


SCHEDULE OF OPENINGS

SL.NO	IND	SIZE
1	D DOOR	1.80 X 2.10
2	D1 DOOR	0.90 X 2.10
3	D2 DOOR	0.75 X 2.10
4	W WINDOW	1.80 X 1.20
5	W1 WINDOW	0.90 X 1.20
6	V VENT	1.80 X 0.45
7	V1 VENT	1.20 X 0.45
8	V2 VENT	0.60 X 0.45
9	CG	COLLAPSIBLE GATE
10	AP	ALUMINIUM PARTITION

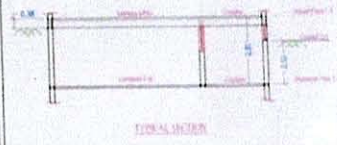

REVISED DATE :15-5-2017
REVISED DATE :01.05.2017

SCALE	1:150
DATE	12-4-2017
DRAWN	BISWAJIT R
CHECKED	MADHAV

BASEMENT FLOOR AS BUILT DRAWING

NEW CREATION LINE ARCHITECTURE
#190/114 12TH MAIN 3 RD BLOCK
RAJAJINAGAR BASHYAM CIRCLE
BANGALORE-560010
cont : 988401567, 0812201296
Email : newcreationlinearchitecture@gmail.com


**MES INSTITUTIONS
RAJAJINAGAR
BANGALORE**

BASEMENT FLOOR

PLINTH AREA- 897.73 SQ.M
CARPET AREA- 779.02Q.M
ROOF HEIGHT- 3.30 M

Sharada S
Principal

**MES Institute of Management
Raiajinagar, Bangalore-560 010**

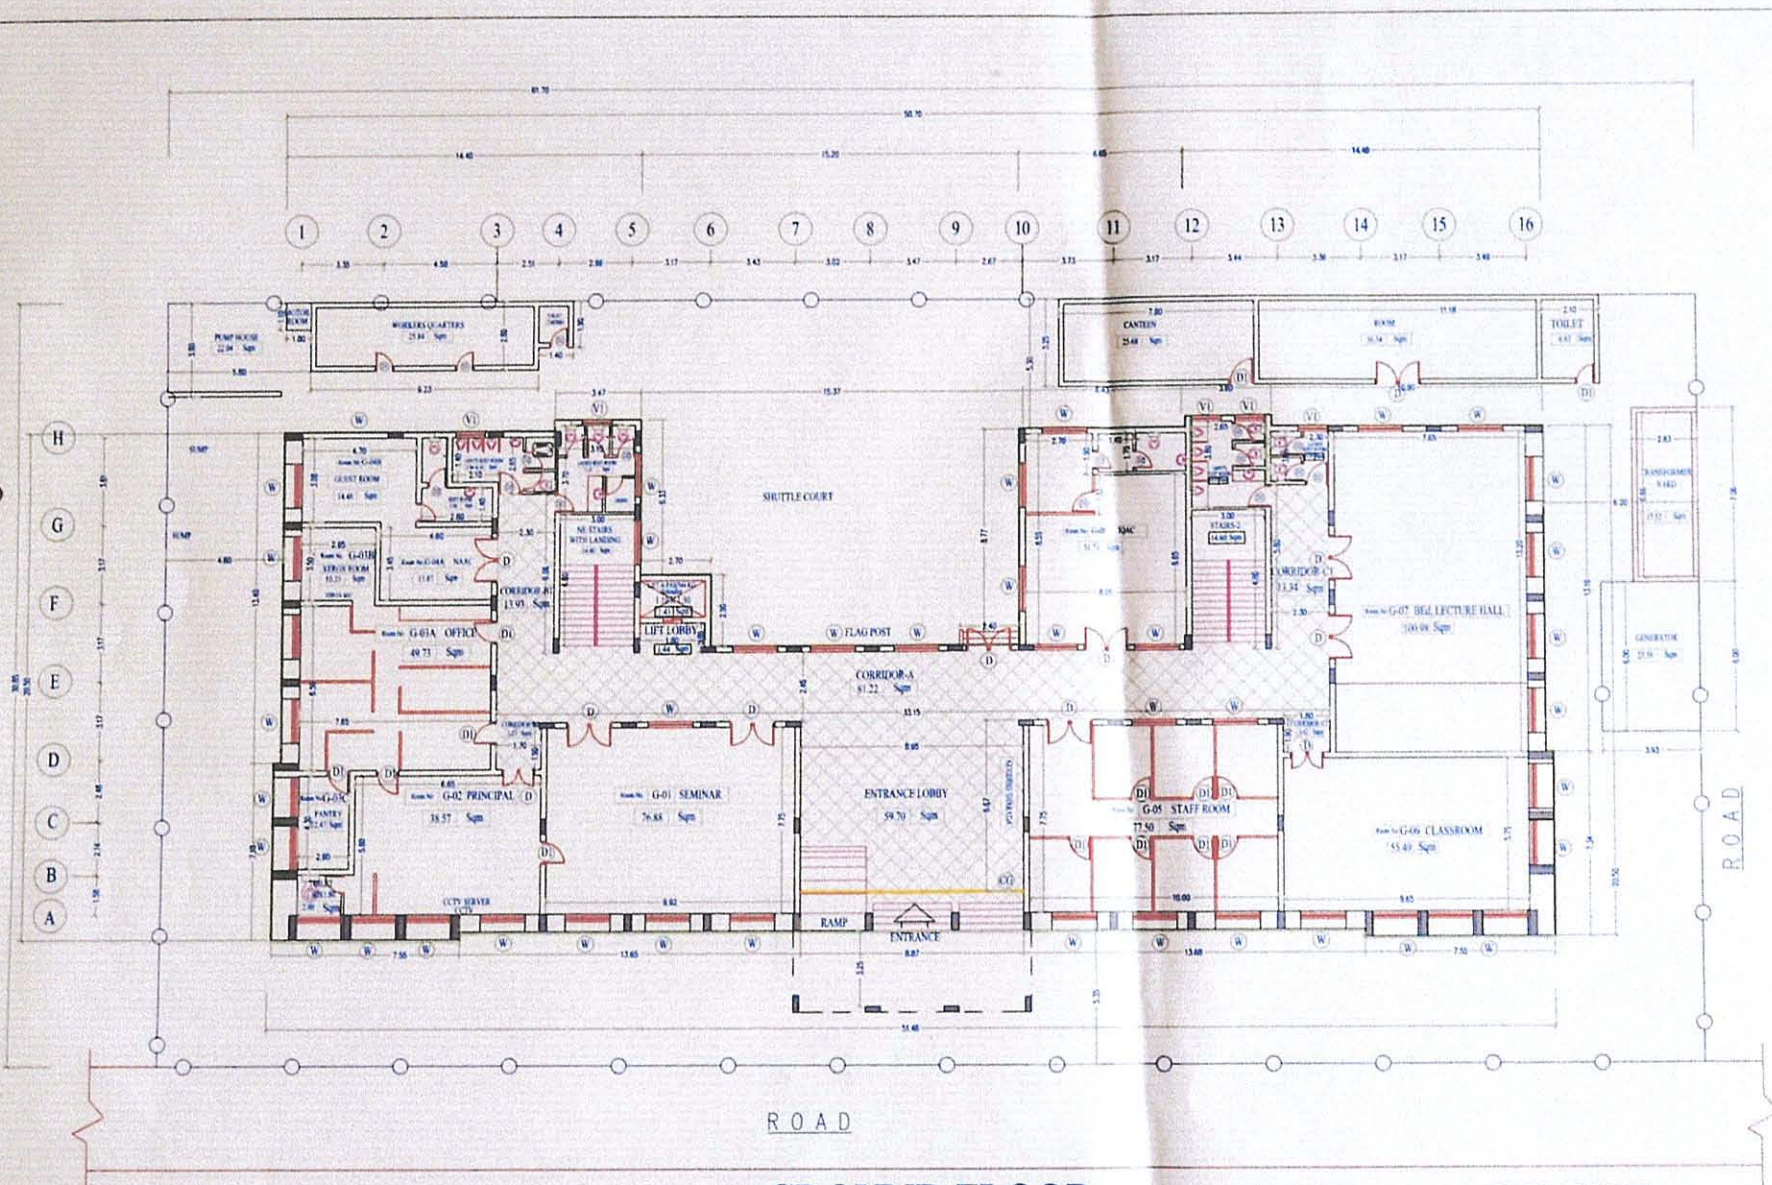


GROUND FLOOR

PLINTH AREA- 1040.83 SQ.M
 CARPET AREA- 916.85 SQ.M
 ROOF HEIGHT- 3.60 M

SCHEDULE OF OPENINGS

SL. NO.	IND.	DESCRIPTION	SIZE
1.	D	DOOR	1.80 X 2.10
2.	D1	DOOR	0.90 X 2.10
3.	D2	DOOR	0.75 X 2.10
4.	W	WINDOW	1.80 X 1.20
5.	W1	WINDOW	0.90 X 1.20
6.	V	VENT.	1.80 X 0.45
7.	V1	VENT.	1.20 X 0.45
8.	V2	VENT.	0.60 X 0.45
9.	CG	COLLAPSIBLE GATE	
10.	AP	ALUMINIUM PARTITION	

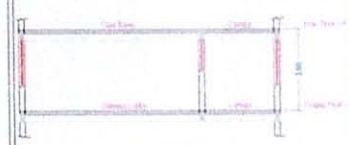

REVISED DATE: 15-5-2017
 REVISED DATE: 01.05.2017

SCALE: 1:150
 DATE: 12-4-2017
 DRAWN: BISWAJIT R
 CHECKED: MADHAV


GROUND FLOOR AS BUILT DRAWING

NEW CREATION LINE ARCHITECTURE
 #190/14/12TH MAIN, 3RD FLOOR
 RAJAJINAGAR BASHYAM CIRCLE
 BANGALORE-560010
 con: 9666491567, 9622201266
 Email: newcreationlinearchitecture@gmail.com

MES INSTITUTIONS
 RAJAJINAGAR
 BANGALORE

Sharada S
 Principal

MES Institute of Management
 Rajajinagar, Bangalore-560 010

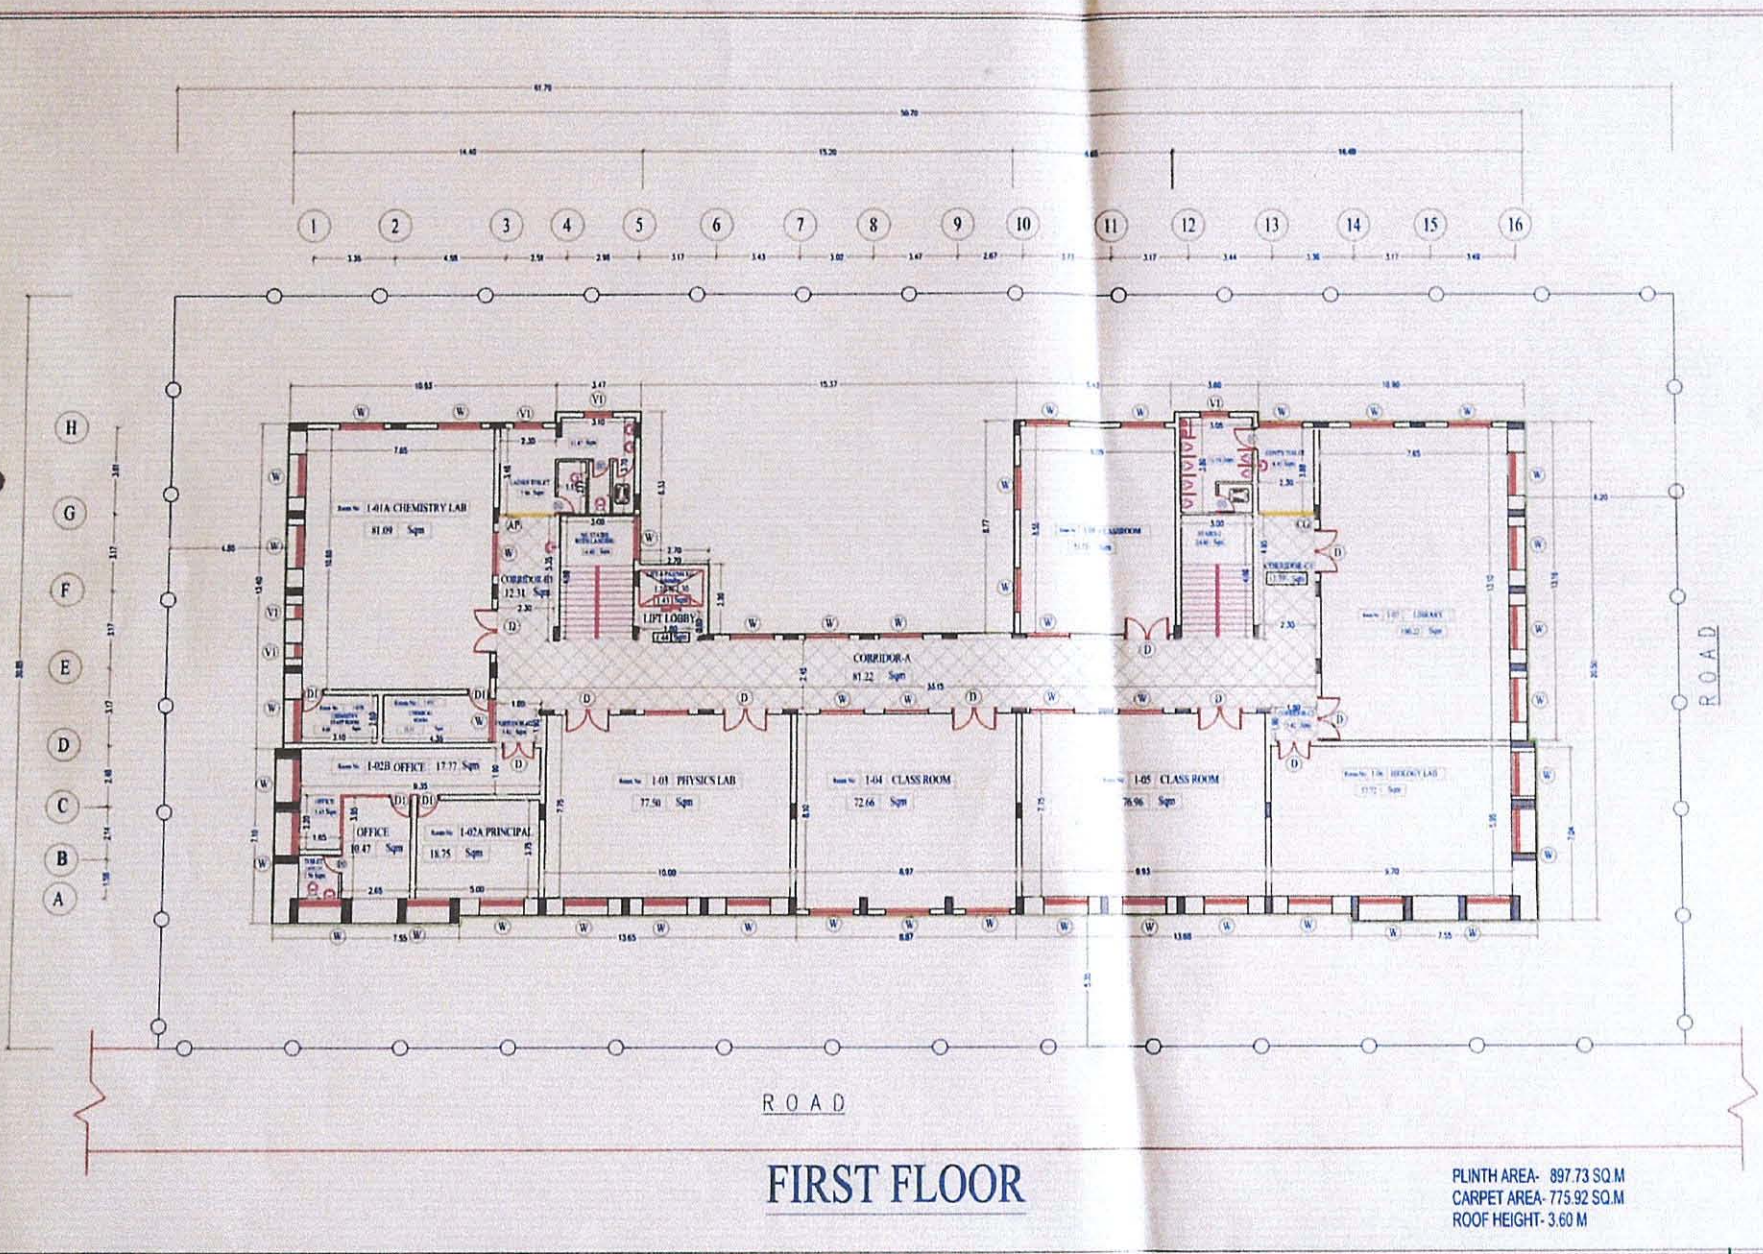


FIRST FLOOR

PLINTH AREA- 897.73 SQ.M
 CARPET AREA- 775.92 SQ.M
 ROOF HEIGHT- 3.60 M

SCHEDULE OF OPENINGS

SL.NO	IND.		SIZE
1.	D	DOOR	1.80 X 2.10
2.	D1	DOOR	0.90 X 2.10
3.	D2	DOOR	0.75 X 2.10
4.	W	WINDOW	1.80 X 1.20
5.	W1	WINDOW	0.90 X 1.20
6.	V	VENT.	1.80 X 0.45
7.	V1	VENT.	1.20 X 0.45
8.	V2	VENT.	0.60 X 0.45
9.	CG	COLLAPSIBLE GATE	
10.	AP	ALUMINIUM PARTITION	

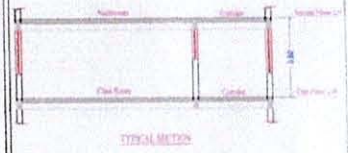

REVISED DATE : 15-5-2017
 REVISED DATE : 01.05.2017

SCALE	1:150
DATE	12-4-2017
DRAWN	BISWAJIT R
CHECKED	MADHAV


FIRST FLOOR AS BUILT DRAWING

NEW CREATION LINE ARCHITECTURE
 #100/14, 12TH MAIN 3 RD BLOCK,
 RAJAJINAGAR BASHYAM CIRCLE
 BANGALORE 560010
 con : 988691567, off : 08033201286
 Email id newcreationlinearchitecture@gmail.com

MES INSTITUTIONS
 RAJAJINAGAR
 BANGALORE

Sharanb.S
 Principal

MES Institute of Management
 Rajajinagar, Bangalore-560 010

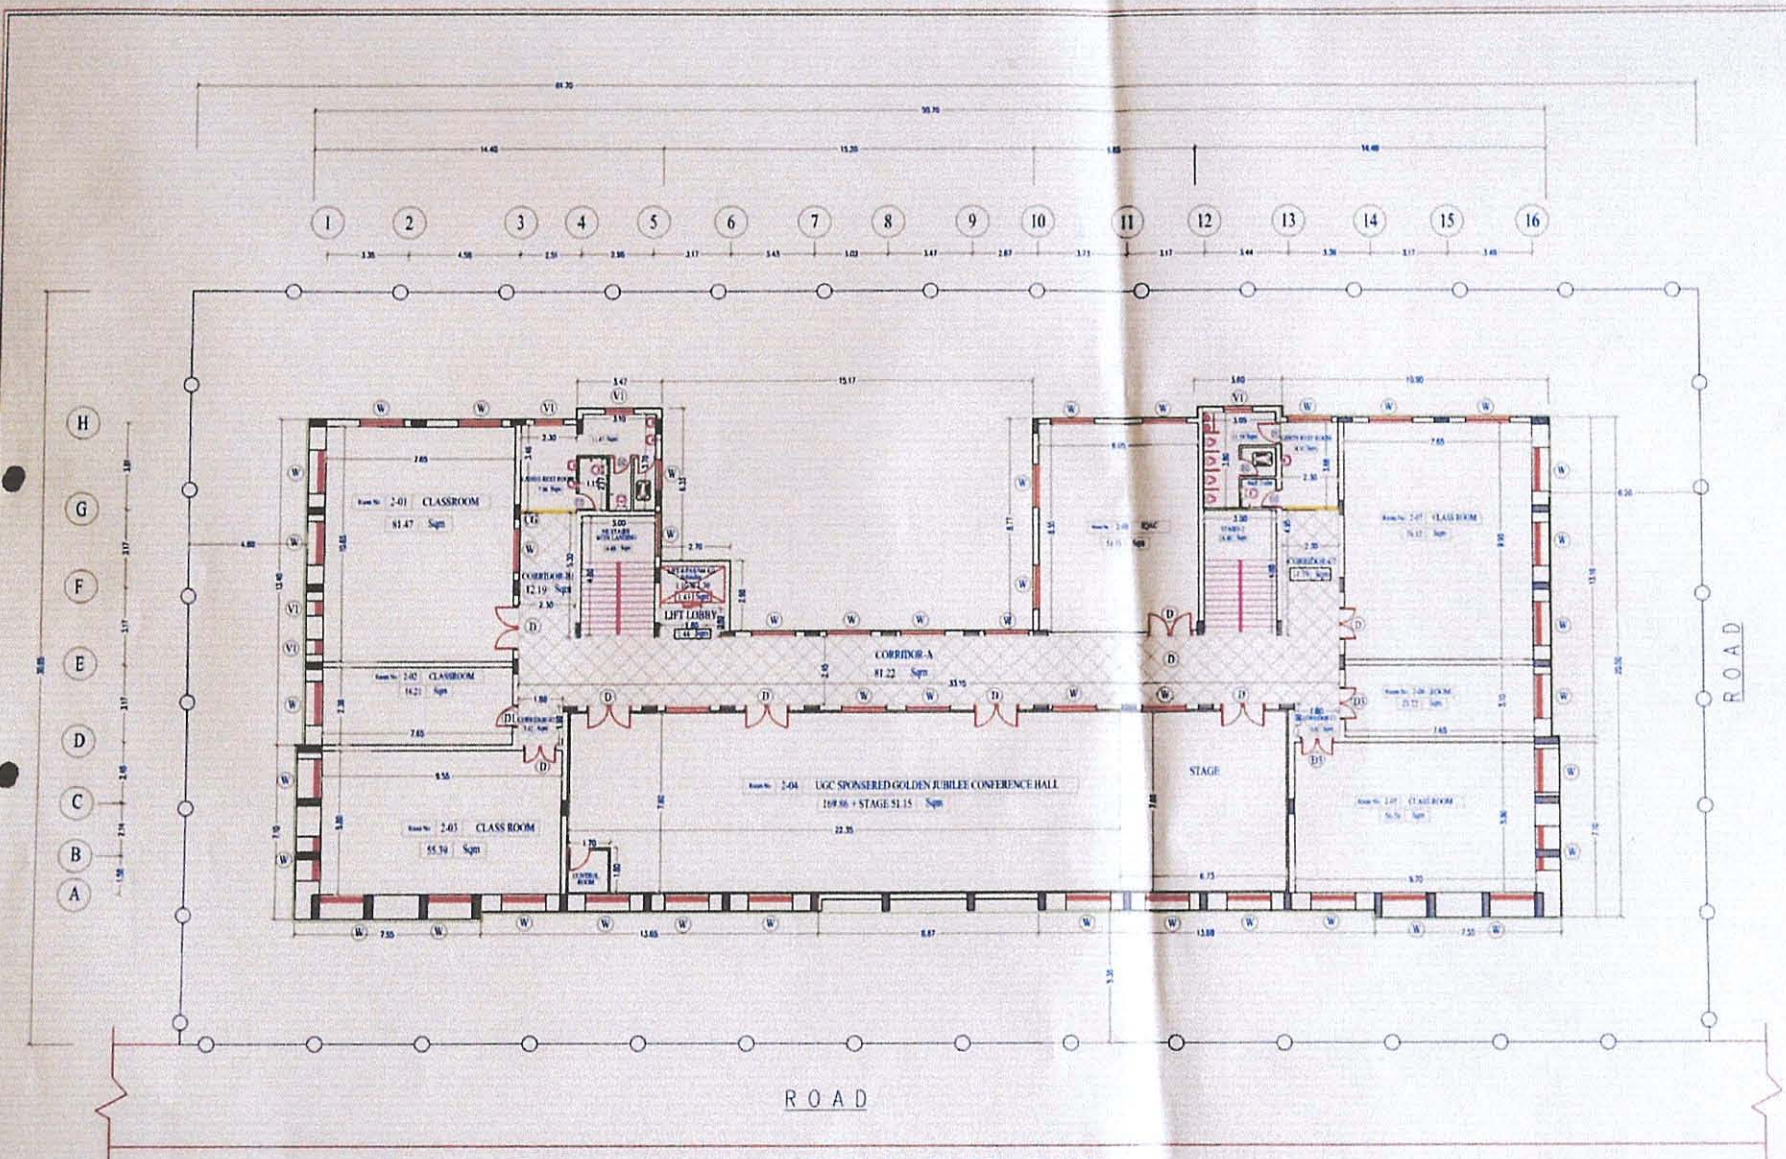


SECOND FLOOR

PLINTH AREA- 897.73 SQ.M
 CARPET AREA- 767.14 SQ.M
 ROOF HEIGHT- 3.60 M

SCHEDULE OF OPENINGS

SL. NO	IND.	DOOR	SIZE
1	D	DOOR	1.80 X 2.10
2	D1	DOOR	0.90 X 2.10
3	D2	DOOR	0.75 X 2.10
4	W	WINDOW	1.80 X 1.20
5	W1	WINDOW	0.90 X 1.20
6	V	VENT.	1.80 X 0.45
7	V1	VENT.	1.20 X 0.45
8	V2	VENT.	0.60 X 0.45
9	CG	COLLAPSIBLE GATE	
10	AP	ALUMINIUM PARTITION	

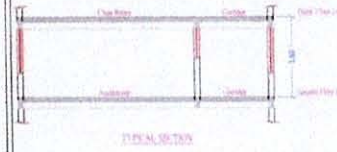

REVISED DATE : 15-5-2017
 REVISED DATE : 01.05.2017

SCALE	1:150
DATE	12-4-2017
DRAWN	BISWAJIT R
CHECKED	MADHAV


SECOND FLOOR AS BUILT DRAWING

NEW CREATION LINE ARCHITECTURE
 #180/14, 12TH MAIN 3 RD BLDK
 RAJAJINAGAR BASHYAM CIRCLE
 BANGALORE-560010
 cont. 986491567, 01-8022201296
 Email: dnewcreationlinearchitecture@gmail.com

MES INSTITUTIONS
 RAJAJINAGAR
 BANGALORE


Sharada S
Principal

MES Institute of Management
 Rajajinagar, Bangalore-560 010

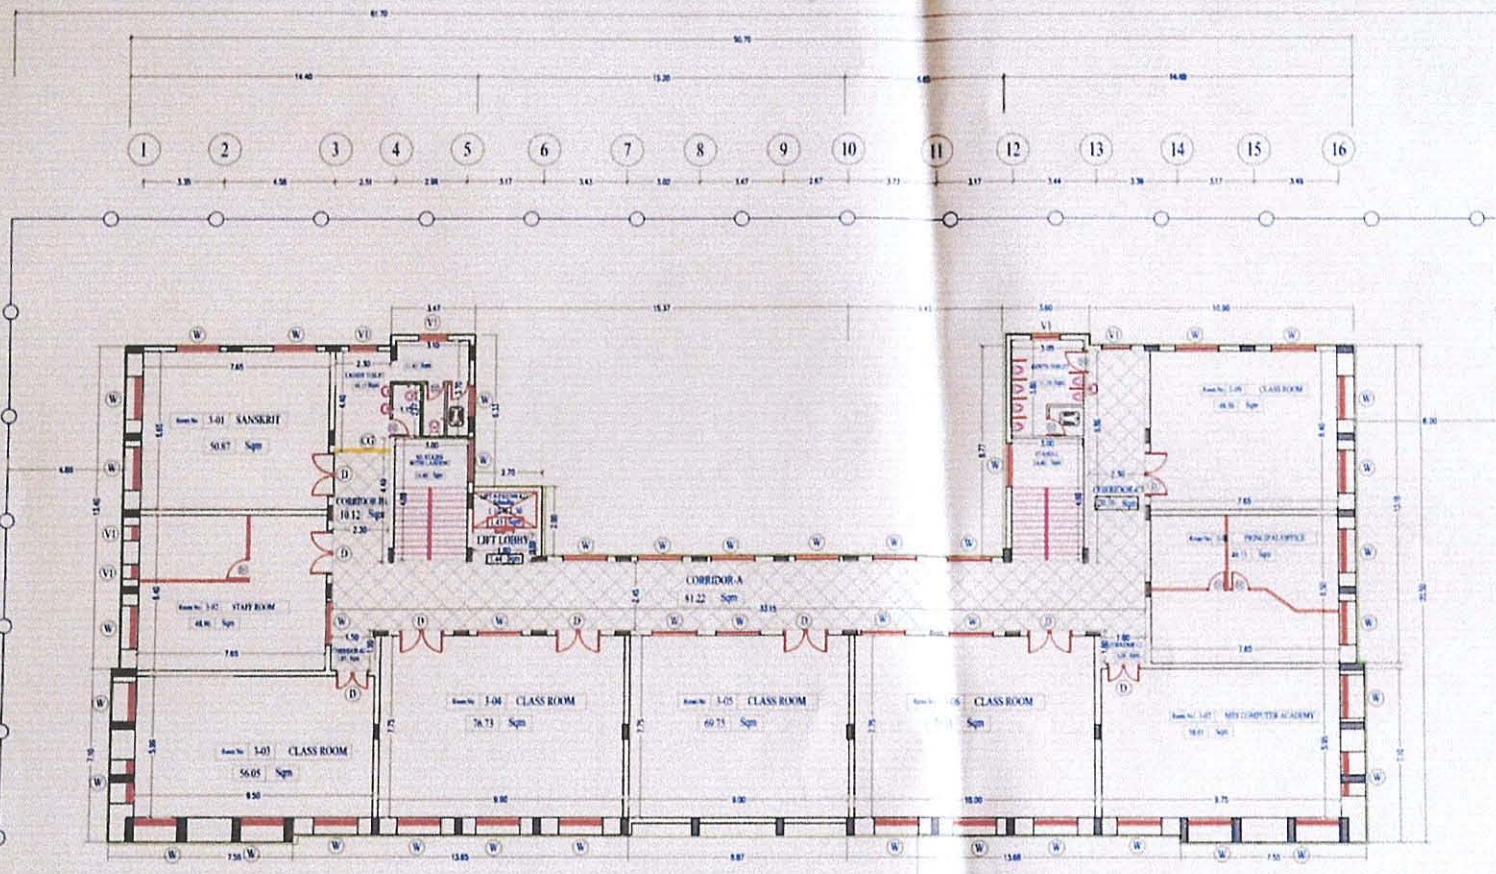

SCHEDULE OF OPENINGS

SL.NO	IND.	SIZE
1.	D DOOR	1.80 X 2.10
2.	D1 DOOR	0.90 X 2.10
3.	D2 DOOR	0.75 X 2.10
4.	W WINDOW	1.80 X 1.20
5.	W1 WINDOW	0.90 X 1.20
6.	V VENT.	1.80 X 0.45
7.	V1 VENT.	1.20 X 0.45
8.	V2 VENT.	0.60 X 0.45
9.	CG	COLLAPSIBLE GATE
10.	AP	ALUMINIUM PARTITION

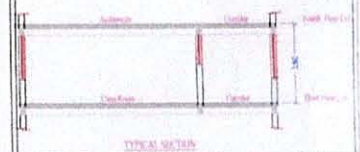

REVISED DATE : 15-5-2017
REVISED DATE : 01.05.2017

SCALE : 1:150
DATE : 12-4-2017
DRAWN : BISWAJIT R
CHECKED : MADHAV

THIRD FLOOR AS BUILT DRAWING

NEW CREATION LINE ARCHITECTURE
#190Y114-12TH MAIN 3 RD BLOCK
RAJAJINAGAR BASHYAM CIRCLE
BANGALORE-560010
cont : 9986491567, 98432021296
Email : newcreationlinearchitecture@gmail.com

**MES INSTITUTIONS
RAJAJINAGAR
BANGALORE**

THIRD FLOOR


PLINTH AREA- 851.50 SQ.M
CARPET AREA- 719.19 SQ.M
ROOF HEIGHT- 3.60 M

Sharada S
Principal

**MES Institute of Management
Rajajinagar, Bangalore-560 010**

SCHEDULE OF OPENINGS

SL NO	IND.		SIZE
1	D	DOOR	1.80 X 2.10
2	D1	DOOR	0.90 X 2.10
3	D2	DOOR	0.75 X 2.10
4	W	WINDOW	1.80 X 1.20
5	W1	WINDOW	0.90 X 1.20
6	V	VENT.	1.80 X 0.45
7	V1	VENT.	1.20 X 0.45
8	V2	VENT.	0.60 X 0.45
9	CG	COLLAPSIBLE GATE	
10	AP	ALUMINIUM PARTITION	

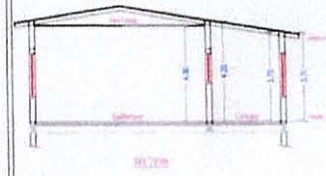

REVISED DATE : 15-5-2017
REVISED DATE : 01.05.2017

SCALE	1:150
DATE	12-4-2017
DRAWN	BISWAJIT R
CHECKED	MADHAV

FOURTH FLOOR AS BUILT DRAWING


NEW CREATION LINE ARCHITECTURE
#190/14, 12TH MAIN, 3RD BLOCK
RAJAJINAGAR, BASHYAM CIRCLE
BANGALORE-560010
cont: 968491967, off: 08023201266
Email: id:newcreationlinearchitect@gmail.com

**MES INSTITUTIONS
RAJAJINAGAR
BANGALORE**

FOURTH FLOOR

PLINTH AREA: 851.20 SQ.M
CARPET AREA: 790.96 SQ.M
ROOF HEIGHT: 3.60 M

Sharaela S

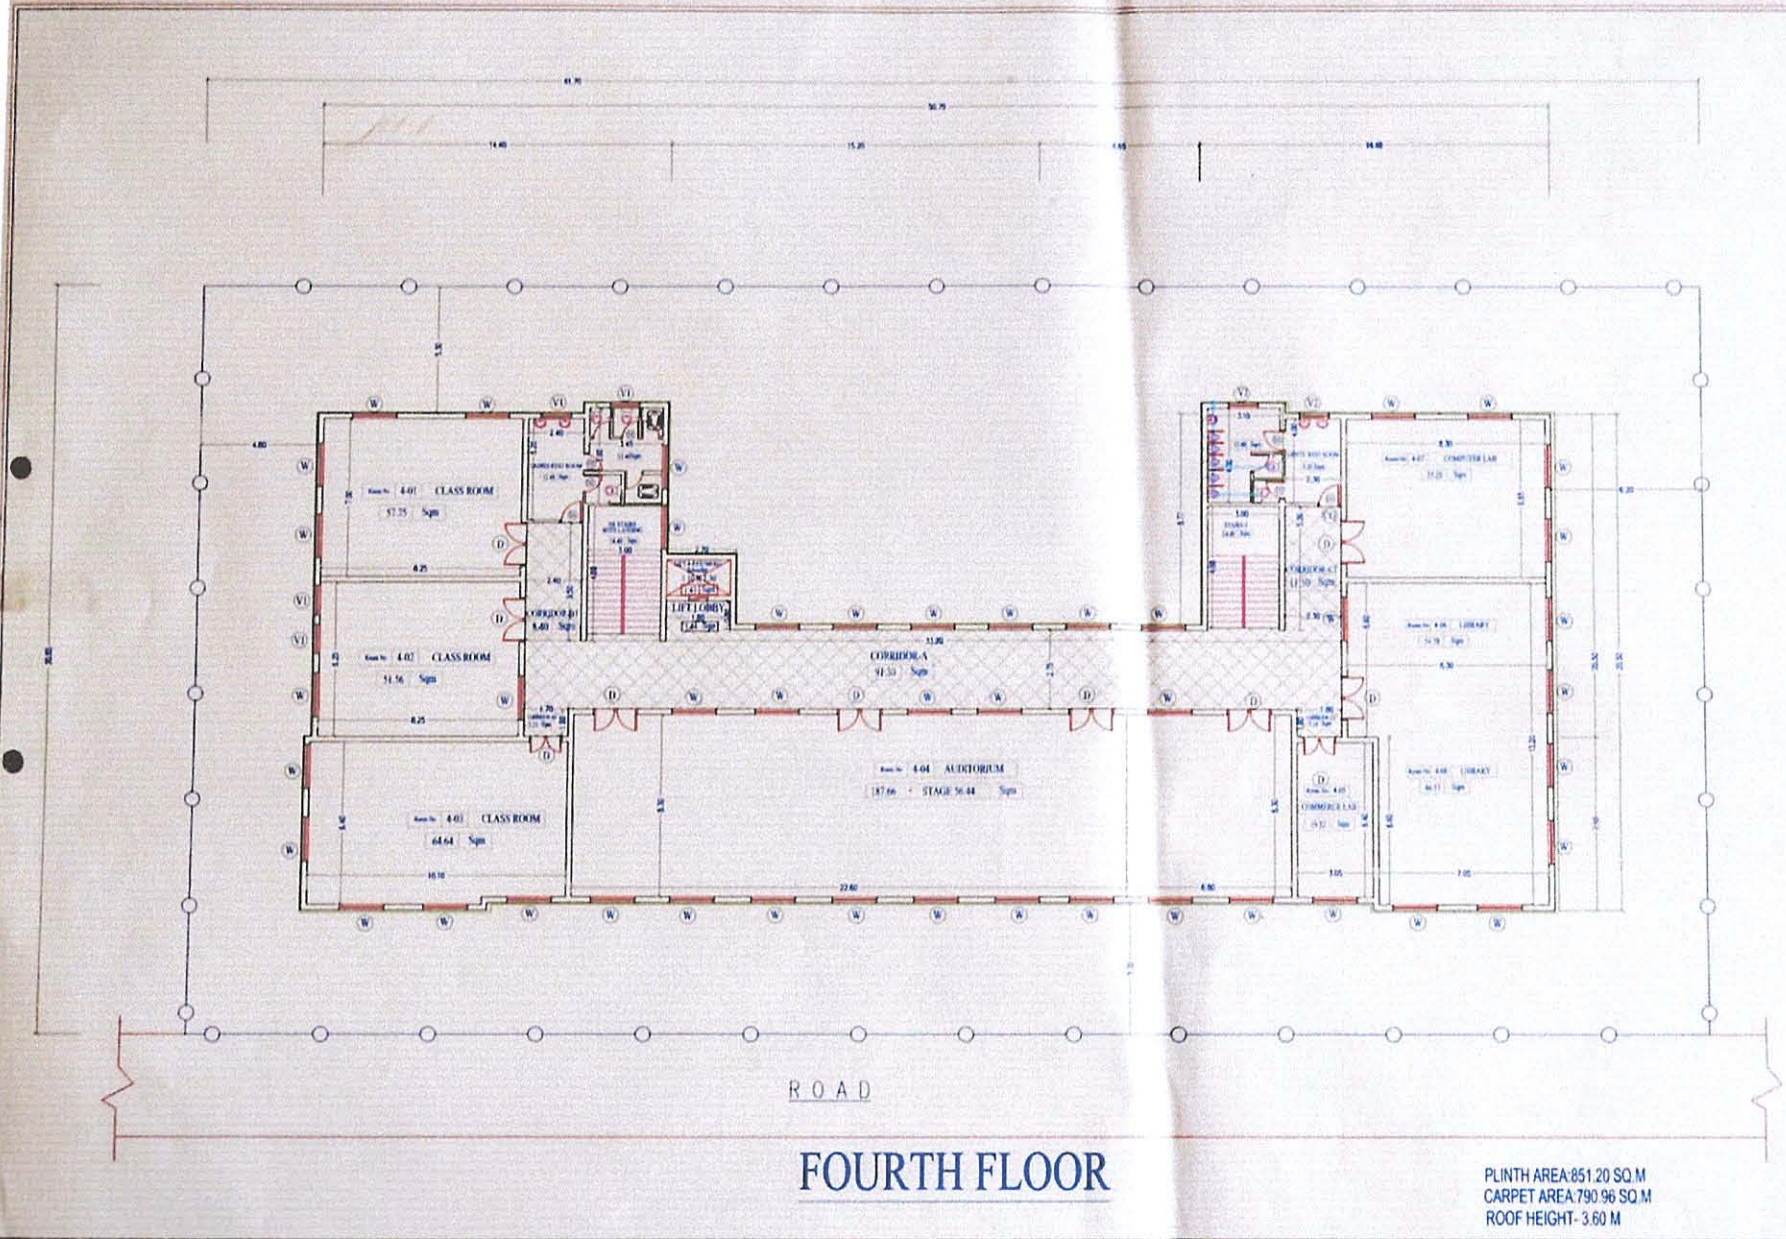


MES INSTITUTE OF MANAGEMENT
Vidyavihar, 25/1,17th Main, II Block, Rajajinagar, Bangalore-560 010

Renovated Third Floor Rest room





Payment Voucher

No. : 653

Dated : 28-Dec-22

Particulars	Amount
Account : REPAIR & MAINTENANCE	5,67,467.00
Less: Tds on Others	(-)5,675.00

364

Through :

SBI SB A/c 64004686044 Principal A/c


On Account of :

ch.no: 326937 , dt : 28.12.2022 , issued in
favour of A 2 Z enterprises as per the bill
enclosed.


Amount (in words) :

INR Five Lakh Sixty One Thousand Seven
Hundred Ninety Two Only

₹ 5,61,792.00

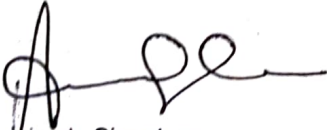

Receiver's Signature:

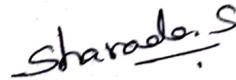

Authorised Signatory




PRINCIPAL

Principal

MES Institute of Management
Rajajinagar

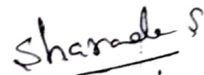

M.E.S. IOM
PAID & CANCELLED
By Ch. No. <u>326937</u>
Date. <u>28/12/22</u>

Principal


M.E.S INSTITUTE OF MANAGEMENT
Vidyavihar, 25/1, 17th Main, II Block, Rajajinagar, Bangalore-560 010

14/10/2022

To,

Chief Executive,
MES Education Society(R),
Malleswaram, Bangalore-560003

Respected Sir,

Subject: Work completion of Renovation of Rest Rooms in 3rd floor

With reference to the above, III floor girls rest room is completely renovated and the keys were handed over on 19th September 2022. The renovation has increased the number of toilets from 3 to 5. Renovation has given very neat and classy look.

The work done is excellent.

Thanking you

Yours faith fully

Principal

PRINCIPAL

MES Institute of Management
Rajajinagar, Bangalore-560 010

CC: Sri.Shivaram (E&M)



Manager (E&M)

Sg
15/10/22



THE MYSORE EDUCATION SOCIETY

No. MES M(E&M) 16 / 2022-23

Date: 07-09-2022

To,
A 2 Z Enterprises
4357, 3rd Cross,
14th Main, Subramanya Nagar,
Bangalore – 560 021.

Subject: Renovation of ladies toilet in 3rd floor of IOM, Rajajinagar.

The work of renovation of ladies toilet block in 3rd of IOM is entrusted to you at prevailing KPWD schedule of rates of Bengaluru circle for civil works.

The stipulated time for completion is ONE (01) month from the date of issue of this work order.

You are informed to meet the Principal, MES IOM, Rajajinagar and Manager (E&M) before commencement of work to take the institution.

K. Naglavendra
Chief Executive 8/9/2022

Copy:

1. Principal, MES IOM, Rajajinagar
2. Manager (F&A)

