


# BASEMENT FLOOR

PLINTH AREA- 897.73 SQ.M  
 CARPET AREA- 779.02Q.M  
 ROOF HEIGHT- 3.30 M

## SCHEDULE OF OPENINGS

SL.NO	IND	SIZE
1	D DOOR	1.80 X 2.10
2	D1 DOOR	0.90 X 2.10
3	D2 DOOR	0.75 X 2.10
4	W WINDOW	1.80 X 1.20
5	W1 WINDOW	0.90 X 1.20
6	V VENT	1.80 X 0.45
7	V1 VENT	1.20 X 0.45
8	V2 VENT	0.60 X 0.45
9	CG	COLLAPSIBLE GATE
10	AP	ALUMINIUM PARTITION

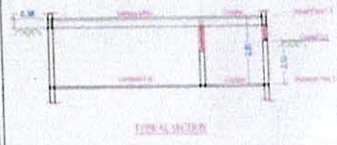

REVISED DATE :15-5-2017  
 REVISED DATE :01.05.2017

SCALE	1:150
DATE	12-4-2017
DRAWN	BISWAJIT R
CHECKED	MADHAV


### BASEMENT FLOOR AS BUILT DRAWING

NEW CREATION LINE ARCHITECTURE  
 #190/114 12TH MAIN 3 RD BLOCK  
 RAJAJINAGAR BASHYAM CIRCLE  
 BANGALORE-560010  
 cont : 988401567, 0812201296  
 Email : newcreationlinearchitecture@gmail.com

MES INSTITUTIONS  
 RAJAJINAGAR  
 BANGALORE

*Sharada S*  
 Principal

MES Institute of Management  
 Rajajinagar, Bangalore-560 010

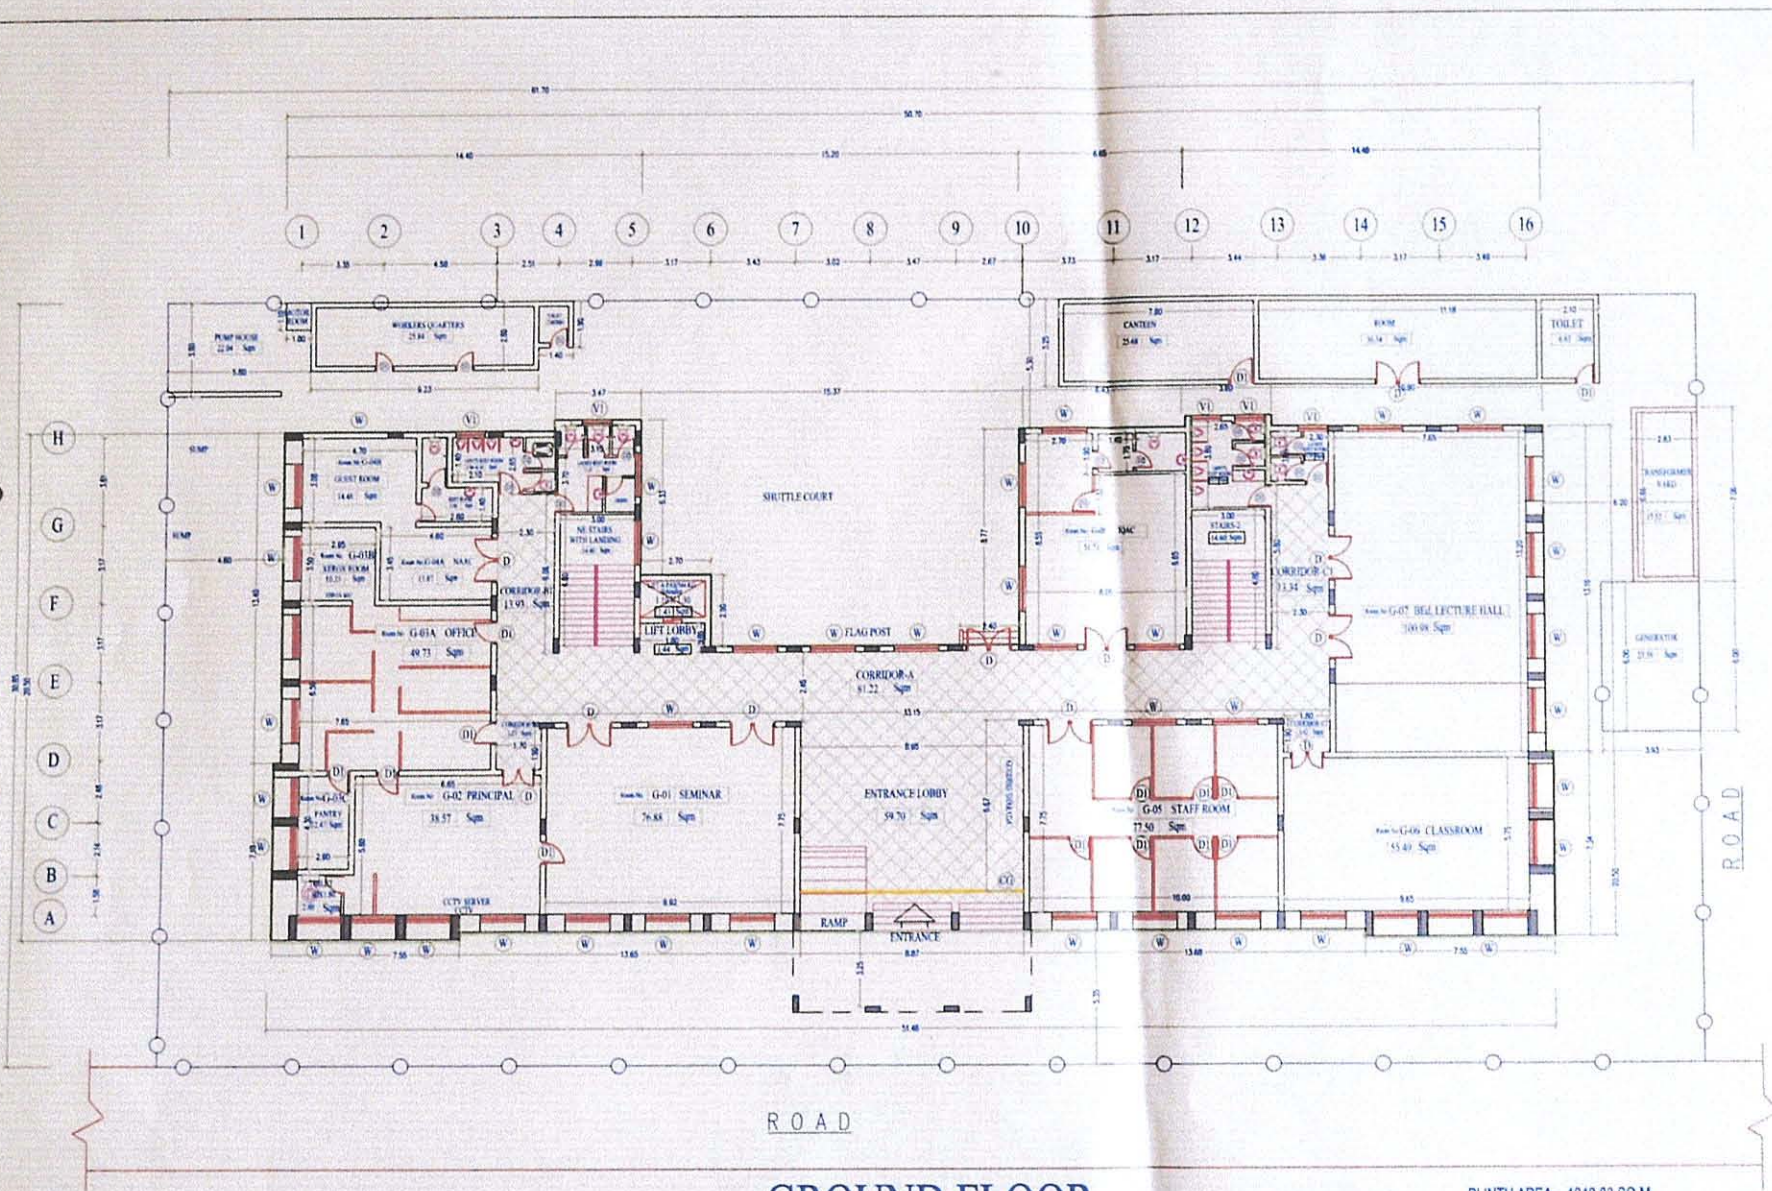


# GROUND FLOOR

PLINTH AREA- 1040.83 SQ.M  
 CARPET AREA- 916.85 SQ.M  
 ROOF HEIGHT- 3.60 M

## SCHEDULE OF OPENINGS

SL. NO.	IND.	DESCRIPTION	SIZE
1.	D	DOOR	1.80 X 2.10
2.	D1	DOOR	0.90 X 2.10
3.	D2	DOOR	0.75 X 2.10
4.	W	WINDOW	1.80 X 1.20
5.	W1	WINDOW	0.90 X 1.20
6.	V	VENT.	1.80 X 0.45
7.	V1	VENT.	1.20 X 0.45
8.	V2	VENT.	0.60 X 0.45
9.	CG	COLLAPSIBLE GATE	
10.	AP	ALUMINIUM PARTITION	

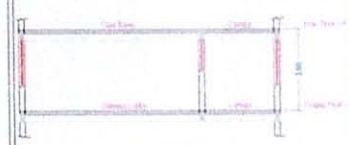

REVISED DATE: 15-5-2017  
 REVISED DATE: 01.05.2017

SCALE: 1:150  
 DATE: 12-4-2017  
 DRAWN: BISWAJIT R  
 CHECKED: MADHAV


## GROUND FLOOR AS BUILT DRAWING

NEW CREATION LINE ARCHITECTURE  
 #190/14/12TH MAIN, 3RD FLOOR  
 RAJAJINAGAR BASHYAM CIRCLE  
 BANGALORE-560010  
 con: 9666491567, 9622201266  
 Email: newcreationlinearchitecture@gmail.com

MES INSTITUTIONS  
 RAJAJINAGAR  
 BANGALORE

*Sharada S*  
 Principal

MES Institute of Management  
 Rajajinagar, Bangalore-560 010

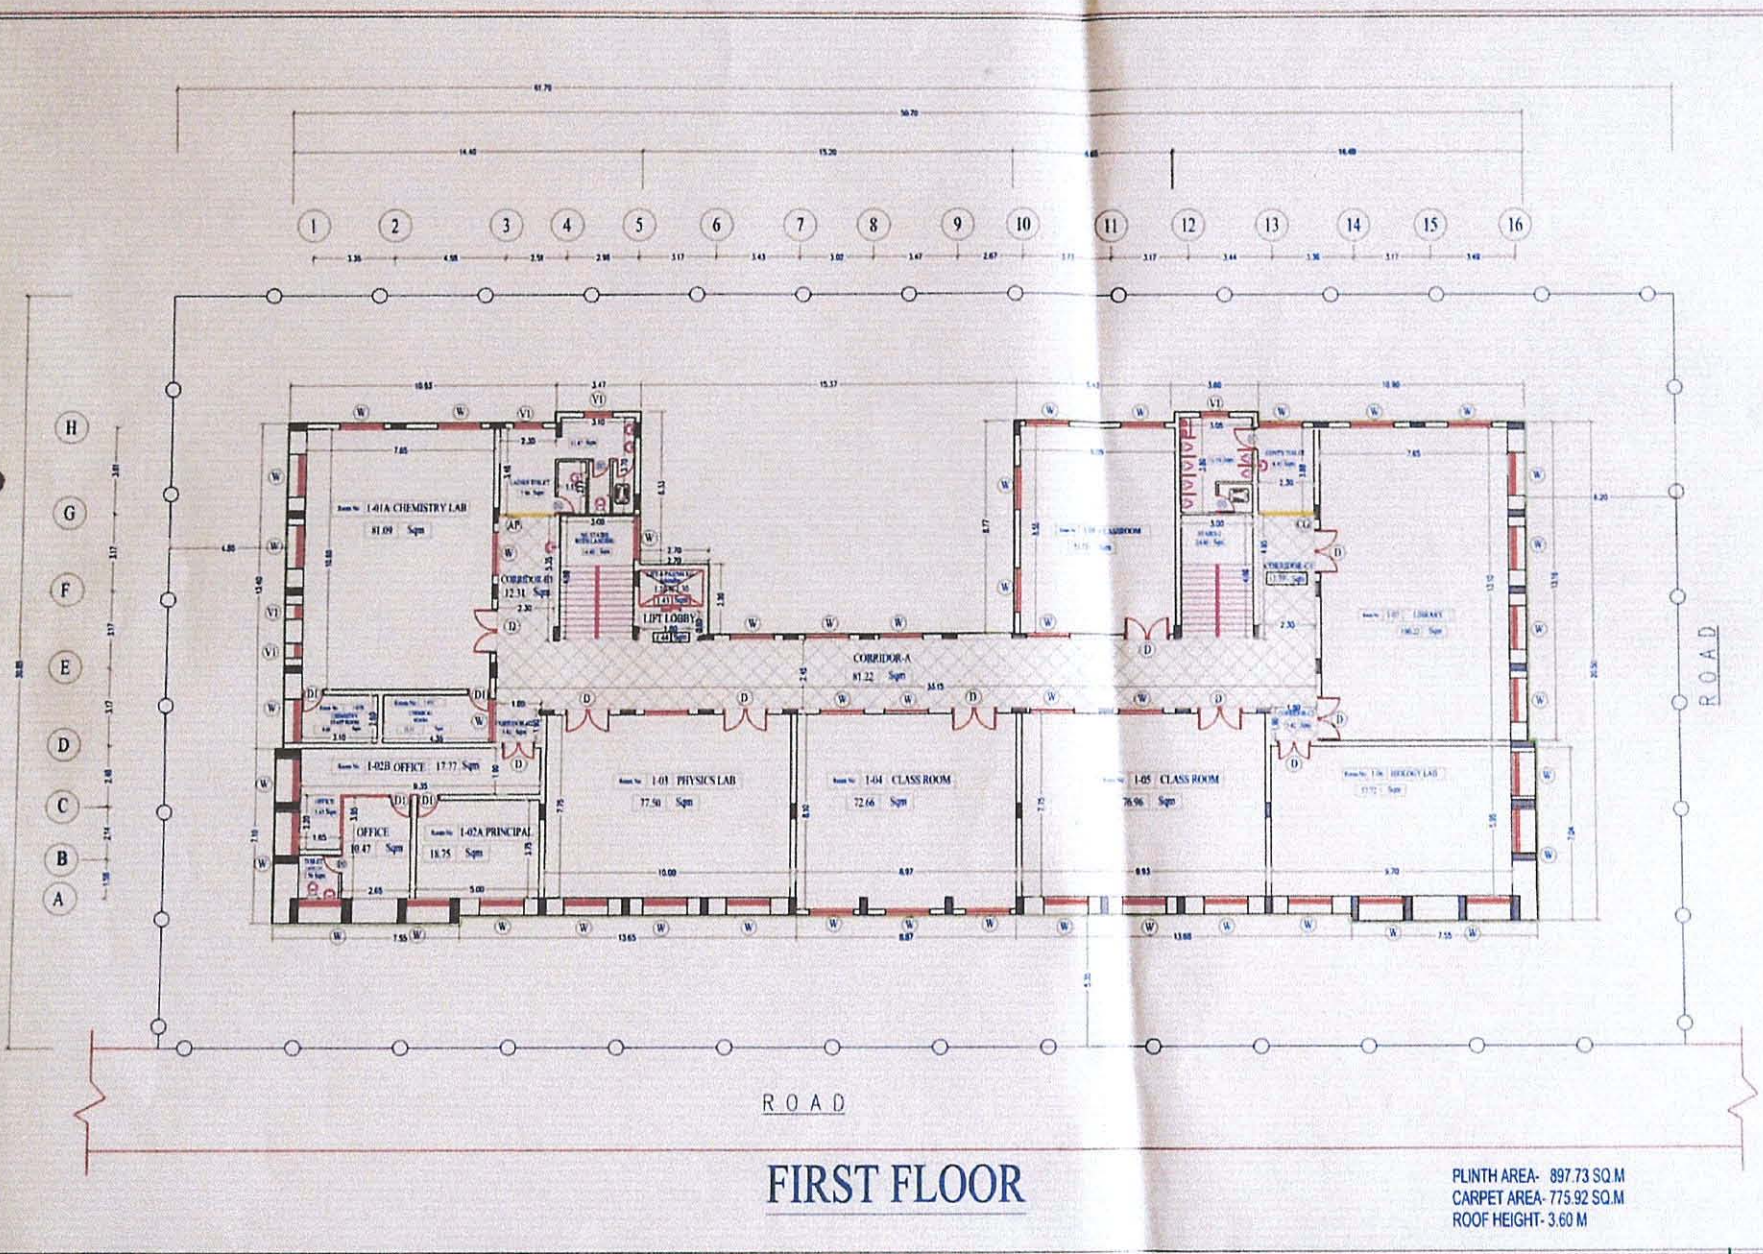


# FIRST FLOOR

PLINTH AREA- 897.73 SQ.M  
 CARPET AREA- 775.92 SQ.M  
 ROOF HEIGHT- 3.60 M

## SCHEDULE OF OPENINGS

SL.NO	IND.	SIZE
1.	D	DOOR 1.80 X 2.10
2.	D1	DOOR 0.90 X 2.10
3.	D2	DOOR 0.75 X 2.10
4.	W	WINDOW 1.80 X 1.20
5.	W1	WINDOW 0.90 X 1.20
6.	V	VENT. 1.80 X 0.45
7.	V1	VENT. 1.20 X 0.45
8.	V2	VENT. 0.60 X 0.45
9.	CG	COLLAPSIBLE GATE
10.	AP	ALUMINIUM PARTITION

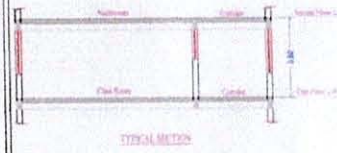

REVISED DATE : 15-5-2017  
 REVISED DATE : 01.05.2017

SCALE	1:150
DATE	12-4-2017
DRAWN	BISWAJIT R
CHECKED	MADHAV


### FIRST FLOOR AS BUILT DRAWING

NEW CREATION LINE ARCHITECTURE  
 #100/14, 12TH MAIN 3 RD BLOCK,  
 RAJAJINAGAR BASHYAM CIRCLE  
 BANGALORE 560010  
 con : 988691567, off : 0823201296  
 Email id newcreationlinearchitecture@gmail.com

MES INSTITUTIONS  
 RAJAJINAGAR  
 BANGALORE

*Sharanb.S*  
 Principal

MES Institute of Management  
 Rajajinagar, Bangalore-560 010

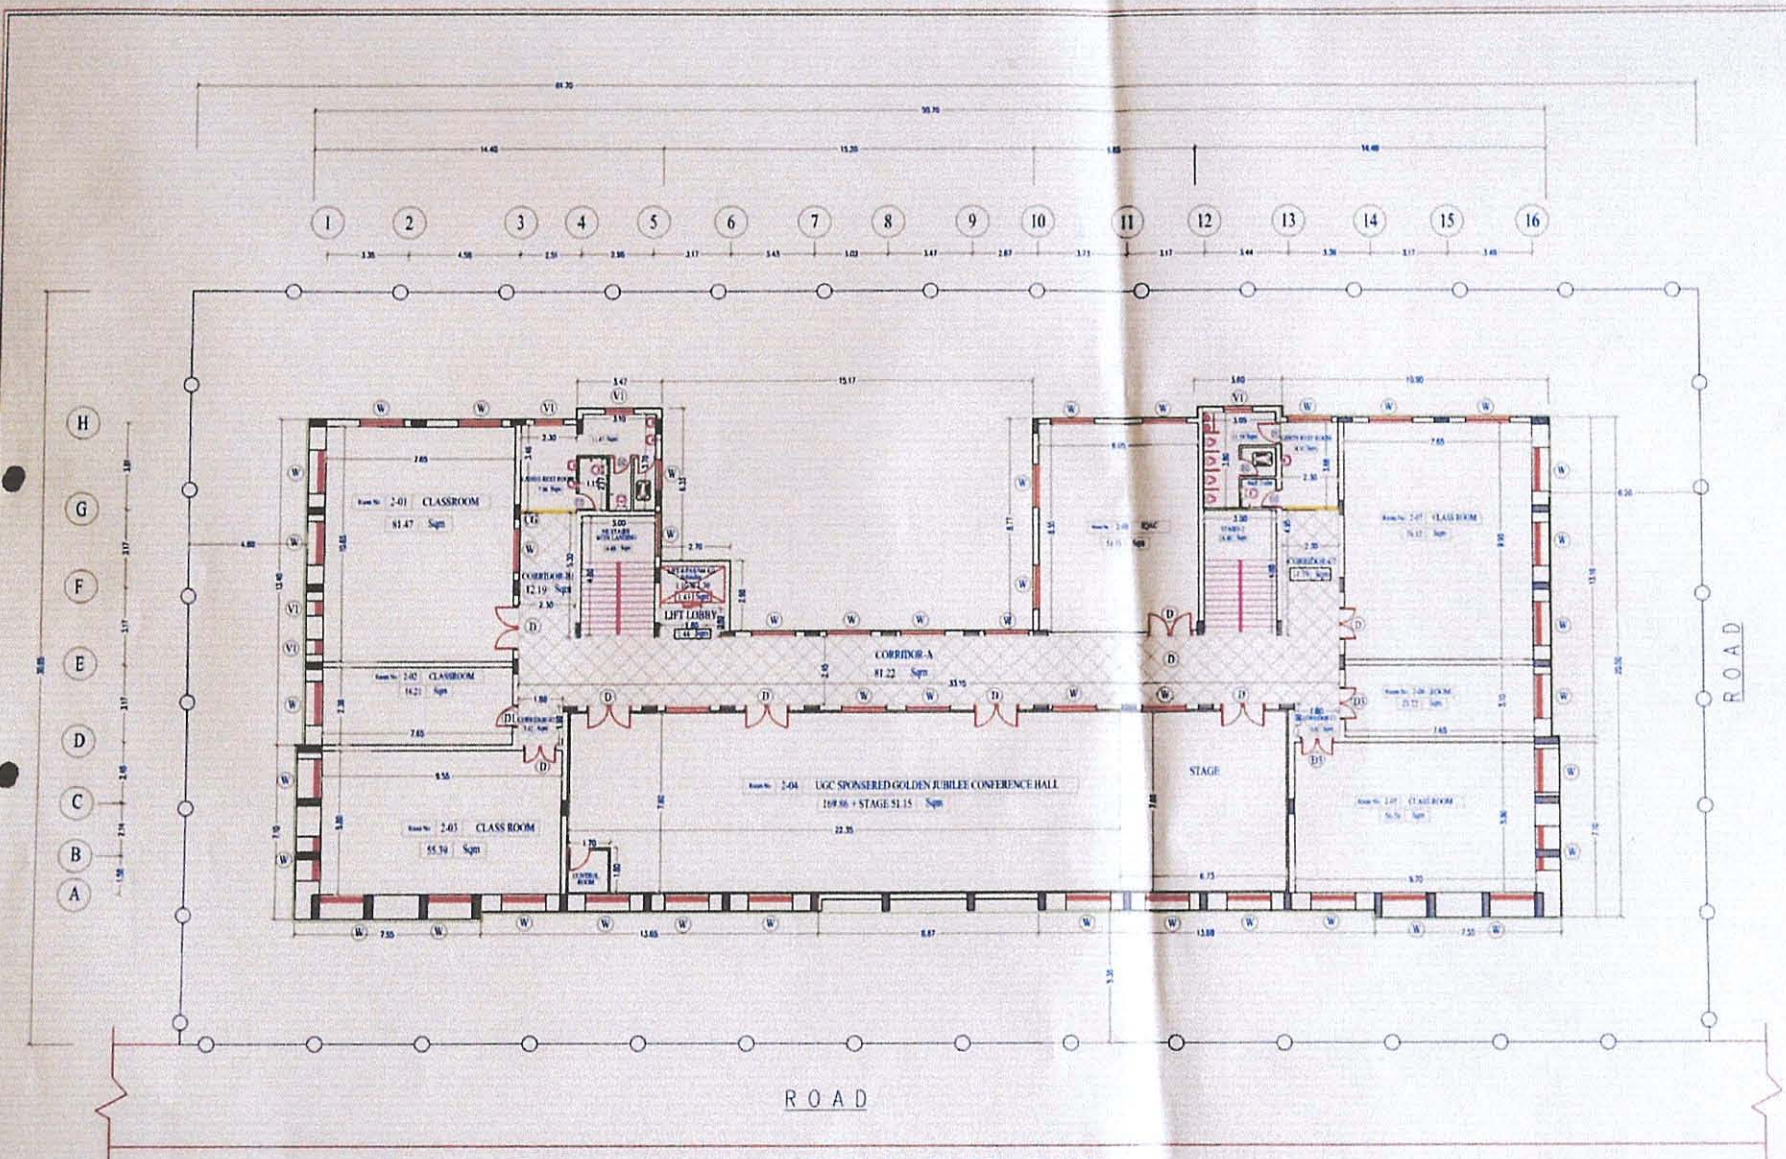


## SECOND FLOOR

PLINTH AREA- 897.73 SQ.M  
 CARPET AREA- 767.14 SQ.M  
 ROOF HEIGHT- 3.60 M

### SCHEDULE OF OPENINGS

SL. NO	IND.	DOOR	SIZE
1	D	DOOR	1.80 X 2.10
2	D1	DOOR	0.90 X 2.10
3	D2	DOOR	0.75 X 2.10
4	W	WINDOW	1.80 X 1.20
5	W1	WINDOW	0.90 X 1.20
6	V	VENT.	1.80 X 0.45
7	V1	VENT.	1.20 X 0.45
8	V2	VENT.	0.60 X 0.45
9	CG	COLLAPSIBLE GATE	
10	AP	ALUMINIUM PARTITION	

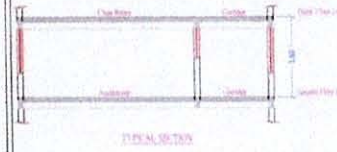

REVISED DATE : 15-5-2017  
 REVISED DATE : 01.05.2017

SCALE	1:150
DATE	12-4-2017
DRAWN	BISWAJIT R
CHECKED	MADHAV


### SECOND FLOOR AS BUILT DRAWING

NEW CREATION LINE ARCHITECTURE  
 #180/14, 12TH MAIN 3 RD BLDK  
 RAJAJINAGAR BASHYAM CIRCLE  
 BANGALORE-560010  
 cont. 986491567, 01-8022301296  
 Email: dnewcreationlinearchitecture@gmail.com


MES INSTITUTIONS  
 RAJAJINAGAR  
 BANGALORE

*Sharada S*  
Principal

MES Institute of Management  
 Rajajinagar, Bangalore-560 010

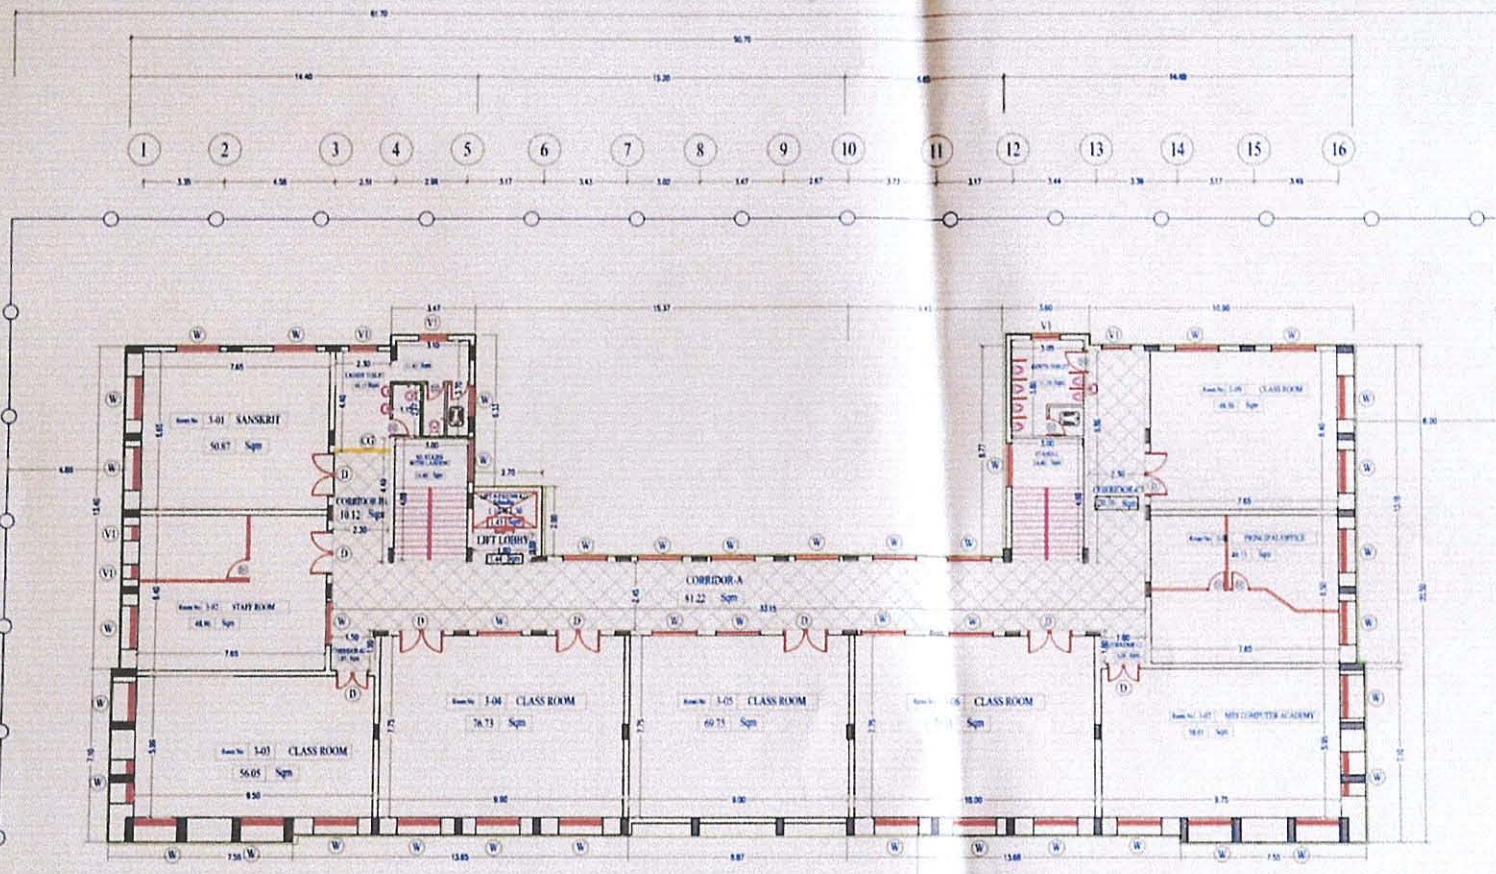

SCHEDULE OF OPENINGS			
SL.NO	IND.		SIZE
1.	D	DOOR	1.80 X 2.10
2.	D1	DOOR	0.90 X 2.10
3.	D2	DOOR	0.75 X 2.10
4.	W	WINDOW	1.80 X 1.20
5.	W1	WINDOW	0.90 X 1.20
6.	V	VENT.	1.80 X 0.45
7.	V1	VENT.	1.20 X 0.45
8.	V2	VENT.	0.60 X 0.45
9.	CG	COLLAPSIBLE GATE	
10.	AP	ALUMINIUM PARTITION	

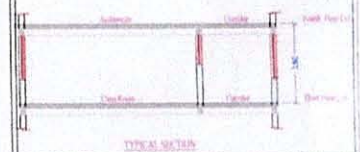

REVISED DATE : 15-5-2017  
 REVISED DATE : 01.05.2017  
 SCALE : 1:150  
 DATE : 12-4-2017  
 DRAWN : BISWAJIT R  
 CHECKED : MADHAV

**THIRD FLOOR  
 AS BUILT DRAWING**

NEW CREATION LINE ARCHITECTURE  
 #190Y114-12TH MAIN 3 RD BLOCK  
 RAJAJINAGAR BASHYAM CIRCLE  
 BANGALORE-560010  
 cont : 9986491567, 98432021296  
 Email : newcreationlinearchitecture@gmail.com

**MES INSTITUTIONS  
 RAJAJINAGAR  
 BANGALORE**

**THIRD FLOOR**


PLINTH AREA- 851.50 SQ.M  
 CARPET AREA- 719.19 SQ.M  
 ROOF HEIGHT- 3.60 M

*Sharada S*  
 Principal

**MES Institute of Management  
 Rajajinagar, Bangalore-560 010**

### SCHEDULE OF OPENINGS

SL NO	IND.		SIZE
1	D	DOOR	1.80 X 2.10
2	D1	DOOR	0.90 X 2.10
3	D2	DOOR	0.75 X 2.10
4	W	WINDOW	1.80 X 1.20
5	W1	WINDOW	0.90 X 1.20
6	V	VENT.	1.80 X 0.45
7	V1	VENT.	1.20 X 0.45
8	V2	VENT.	0.60 X 0.45
9	CG	COLLAPSIBLE GATE	
10	AP	ALUMINIUM PARTITION	

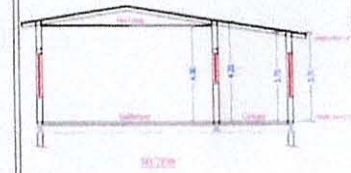

REVISED DATE : 15-5-2017  
REVISED DATE : 01.05.2017

SCALE : 1:150  
DATE : 12-4-2017  
DRAWN : BISWAJIT R  
CHECKED : MADHAV

### FOURTH FLOOR AS BUILT DRAWING

NEW CREATION LINE ARCHITECTURE  
#190/14, 12TH MAIN, 3RD BLOCK  
RAJAJINAGAR, BASHYAM CIRCLE  
BANGALORE-560010  
cont: 968491967, off: 0823201266  
Email: id:newcreationlinearchitect@gmail.com

MES INSTITUTIONS  
RAJAJINAGAR  
BANGALORE

## FOURTH FLOOR

PLINTH AREA: 851.20 SQ.M  
CARPET AREA: 790.96 SQ.M  
ROOF HEIGHT: 3.60 M

*Sharaela S*

