


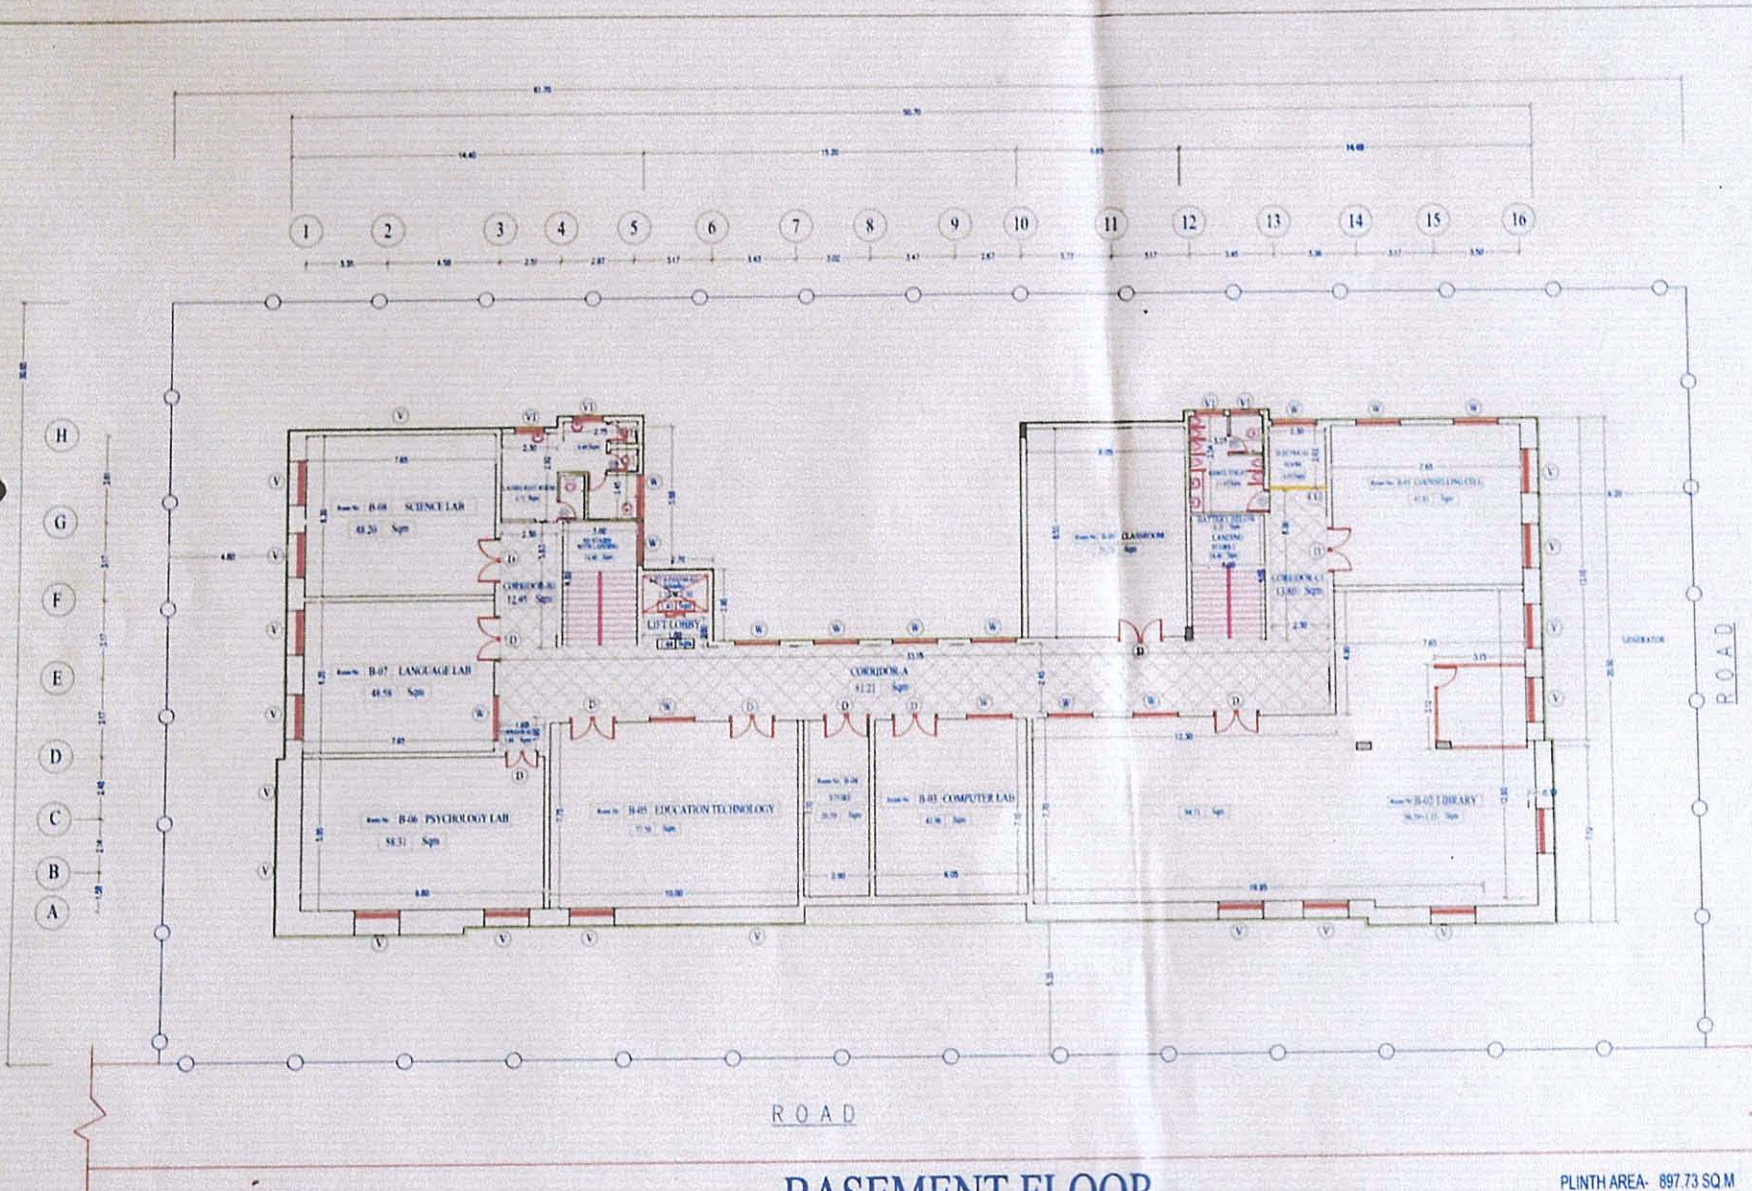


BASEMENT FLOOR

PLINTH AREA- 897.73 SQ.M
CARPET AREA- 779.02Q.M
ROOF HEIGHT- 3.30 M

SCHEDULE OF OPENINGS

SL.NO	IND	SIZE
1	D DOOR	1.80 X 2.10
2	D1 DOOR	0.90 X 2.10
3	D2 DOOR	0.75 X 2.10
4	W WINDOW	1.80 X 1.20
5	W1 WINDOW	0.90 X 1.20
6	V VENT	1.80 X 0.45
7	V1 VENT	1.20 X 0.45
8	V2 VENT	0.60 X 0.45
9	CG	COLLAPSIBLE GATE
10	AP	ALUMINIUM PARTITION

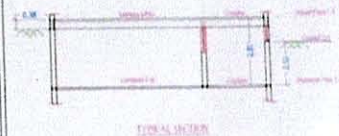

NORTH

REVISED DATE : 15-5-2017
REVISED DATE : 01.05.2017

SCALE : 1:150
DATE : 12-4-2017
DRAWN : BISWAJIT R
CHECKED : MADHAV


BASEMENT FLOOR
AS BUILT DRAWING

NEW CREATION LINE ARCHITECTURE
#190/114 12TH MAIN 3 RD BLOCK
RAJAJINAGAR BASHYAM CIRCLE
BANGALORE-560019
cont : 986401567, 01-5872201286
Email : newcreationlinearchitecture@gmail.com

MES INSTITUTIONS
RAJAJINAGAR
BANGALORE


Sharada S
Principal

MES Institute of Management
Rajajinagar, Bangalore-560 010

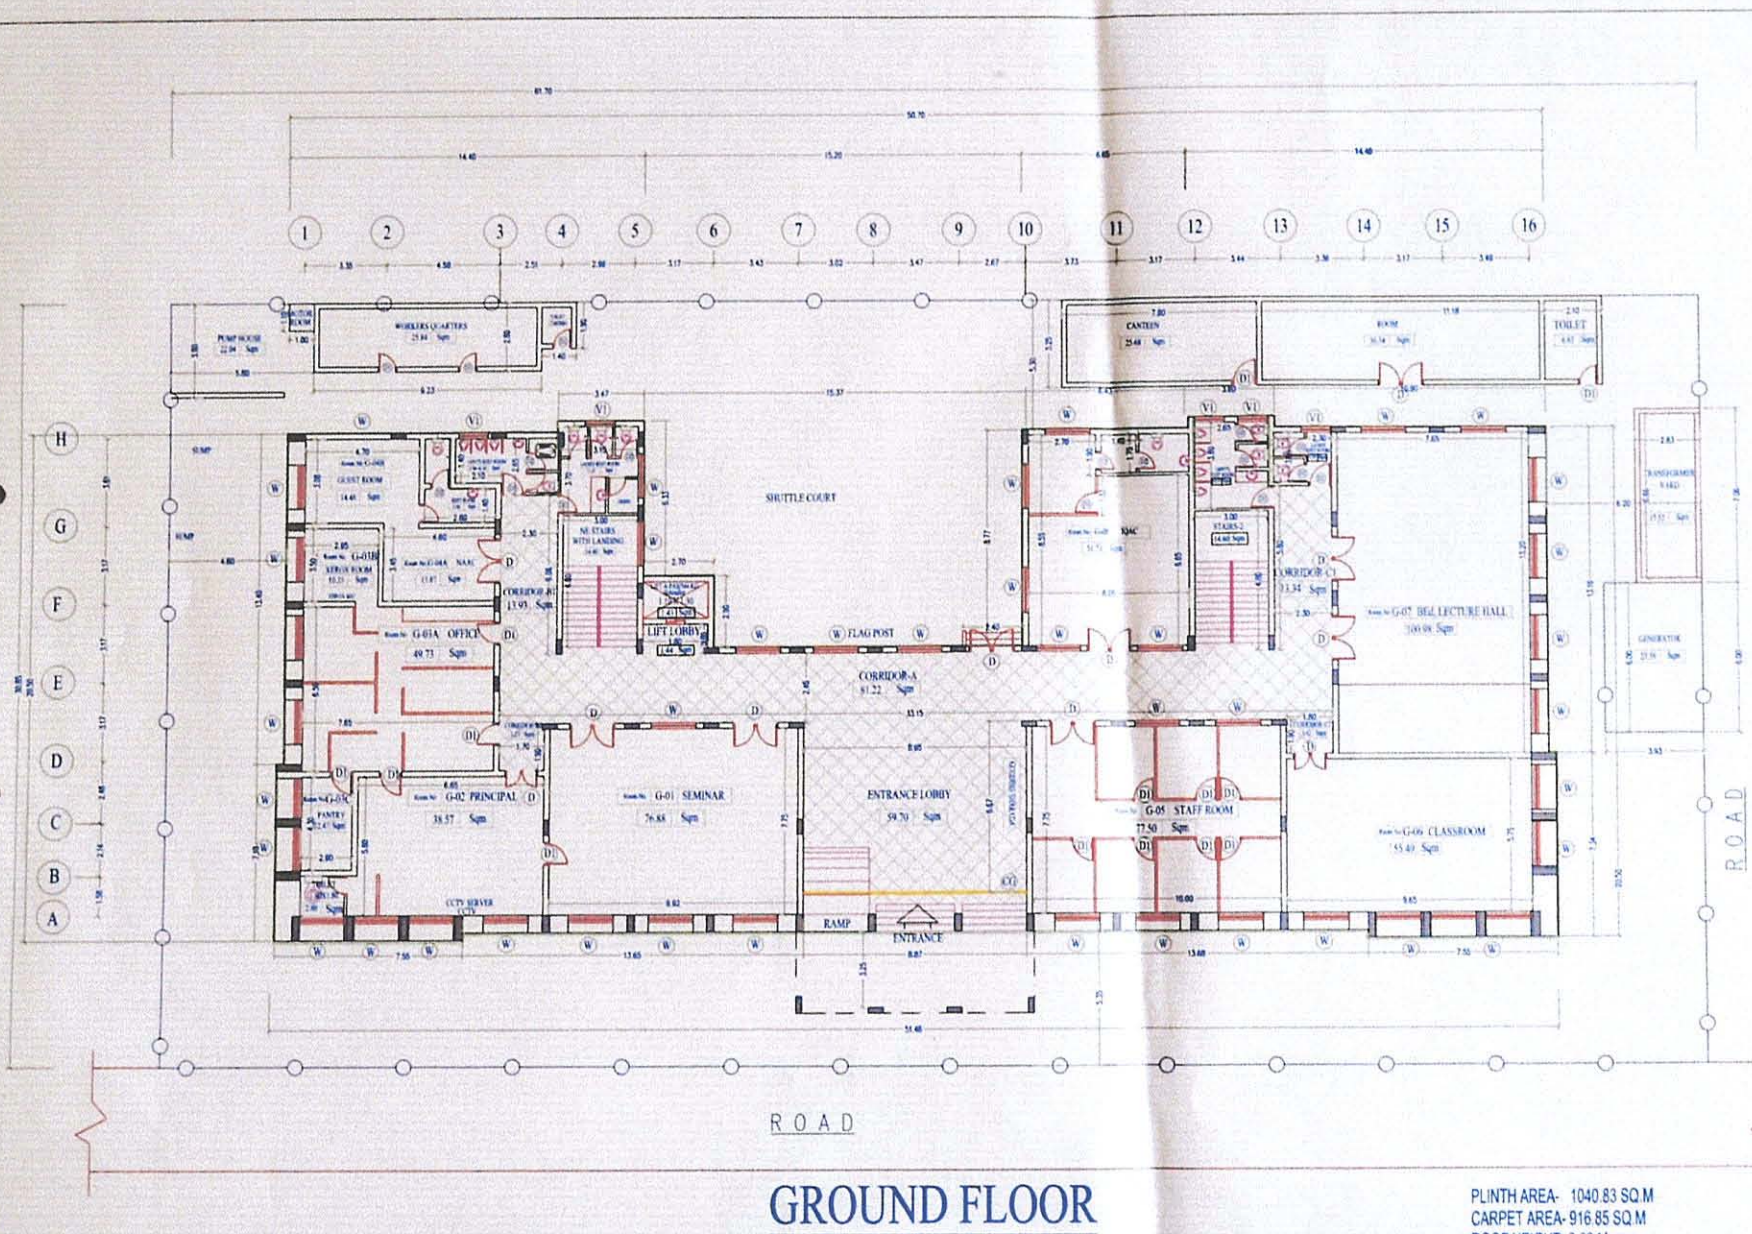

SCHEDULE OF OPENINGS

SL. NO.	IND.	SIZE
1.	D	DOOR 1.80 X 2.10
2.	D1	DOOR 0.90 X 2.10
3.	D2	DOOR 0.75 X 2.10
4.	W	WINDOW 1.80 X 1.20
5.	W1	WINDOW 0.90 X 1.20
6.	V	VENT. 1.80 X 0.45
7.	V1	VENT. 1.20 X 0.45
8.	V2	VENT. 0.60 X 0.45
9.	CG	COLLAPSIBLE GATE
10.	AP	ALUMINIUM PARTITION

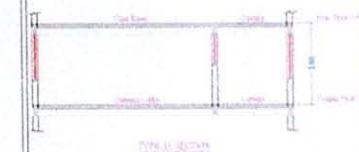

NORTH

REVISED DATE 15-5-2017

REVISED DATE 01.05.2017

SCALE	1:150
DATE	12-4-2017
DRAWN	BISWAJIT R
CHECKED	MADHAV


GROUND FLOOR AS BUILT DRAWING

NEW CREATION LINE ARCHITECTURE
#190/14 12TH MAIN 3 RD BLOCK
RAJAJINAGAR BASHYAM CIRCLE
BANGALORE-560010
con: 966491567, 9822201266
Email: id: newcreationlinearchitecture@gmail.com

MES INSTITUTIONS
RAJAJINAGAR
BANGALORE


Sharada S
Principal

MES Institute of Management
Rajajinagar, Bangalore-560 010

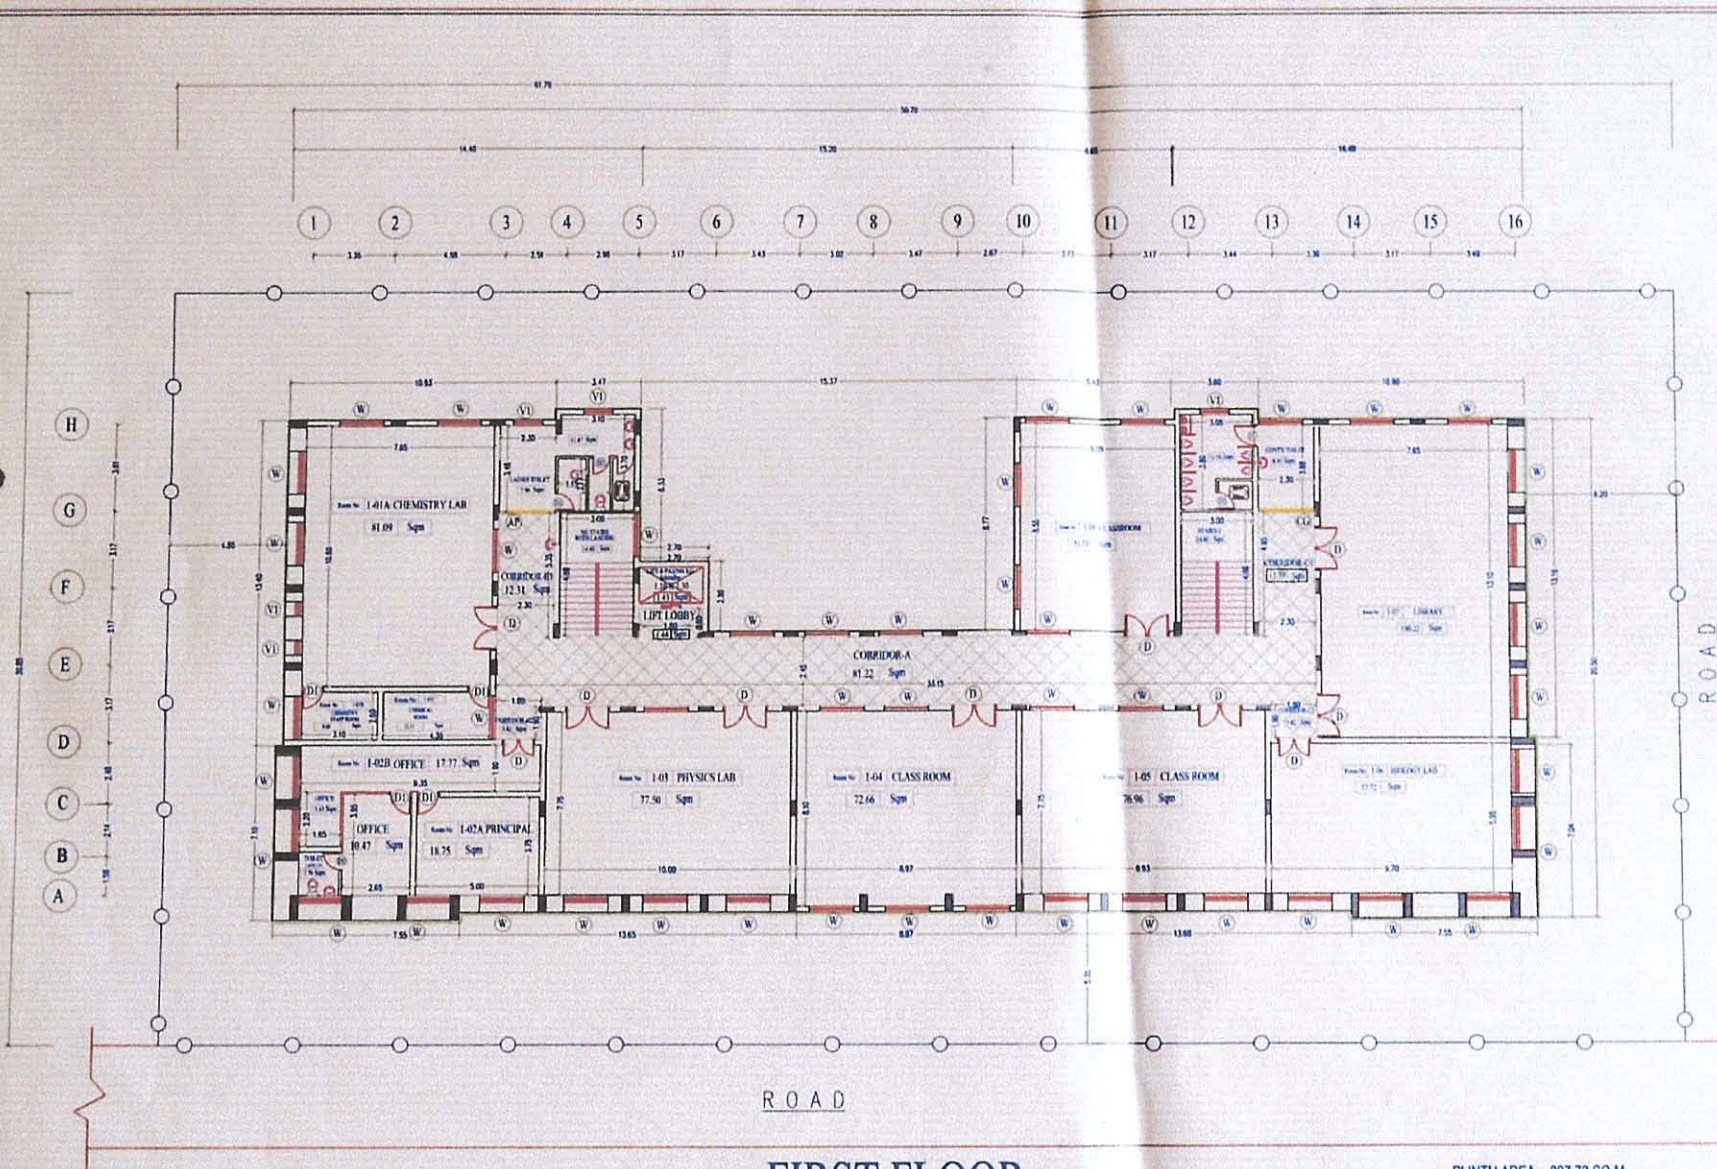

SCHEDULE OF OPENINGS

SL.NO	IND.	SIZE
1.	D DOOR	1.80 X 2.10
2.	D1 DOOR	0.90 X 2.10
3.	D2 DOOR	0.75 X 2.10
4.	W WINDOW	1.80 X 1.20
5.	W1 WINDOW	0.90 X 1.20
6.	V VENT.	1.80 X 0.45
7.	V1 VENT.	1.20 X 0.45
8.	V2 VENT.	0.60 X 0.45
9.	CG COLLAPSIBLE GATE	
10.	AP ALUMINIUM PARTITION	

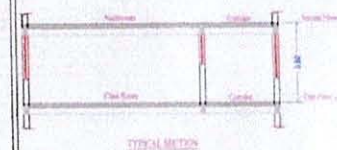

REVISED DATE : 15-5-2017

REVISED DATE : 01.05.2017

SCALE : 1:150
DATE : 12-4-2017
DRAWN : BISWAJIT R
CHECKED : MADHAV

**FIRST FLOOR
AS BUILT DRAWING**

NEW CREATION LINE ARCHITECTURE
#100/14, 12TH MAIN 3 RD BLOCK,
RAJAJINAGAR BASHYAM CIRCLE
BANGALORE 560010
con : 9886491567, off : 08233201296
Email id: newcreationlinearchitecture@gmail.com


**MES INSTITUTIONS
RAJAJINAGAR
BANGALORE**

Sharada S
Principal

**MES Institute of Management
Raajinagar, Bangalore-560 010**

SCHEDULE OF OPENINGS

Sl. No	IND		SIZE
1.	D	DOOR	1.80 X 2.10
2.	D1	DOOR	0.90 X 2.10
3.	D2	DOOR	0.75 X 2.10
4.	W	WINDOW	1.80 X 1.20
5.	W1	WINDOW	0.90 X 1.20
6.	V	VENT.	1.80 X 0.45
7.	V1	VENT.	1.20 X 0.45
8.	V2	VENT.	0.60 X 0.45
9.	CG	COLLAPSIBLE GATE	
10.	AP	ALUMINIUM PARTITION	

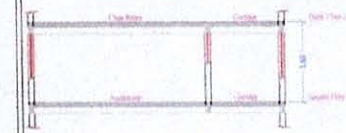

NORTH

REVISED DATE : 15-5-2017

REVISED DATE : 01.05.2017

SCALE	1:150
DATE	12-4-2017
DRAWN	BISWAJIT R
CHECKED	MADHAV

SECOND FLOOR AS BUILT DRAWING

NEW CREATION LINE ARCHITECTURE
#180/14, 11TH MAIN 3 RD BLDG
RAJAJINAGAR BASHYAM CIRCLE
BANGALORE-560010
cont. 9886491567, 9822201296
Email: newcreationlinearchitecture@gmail.com


MES INSTITUTIONS
RAJAJINAGAR
BANGALORE

SECOND FLOOR

PLINTH AREA- 897.73 SQ.M
CARPET AREA- 767.14 SQ.M
ROOF HEIGHT- 3.60 M

Sharada S
Principal

MES Institute of Management
Rajajinagar, Bangalore-560 010

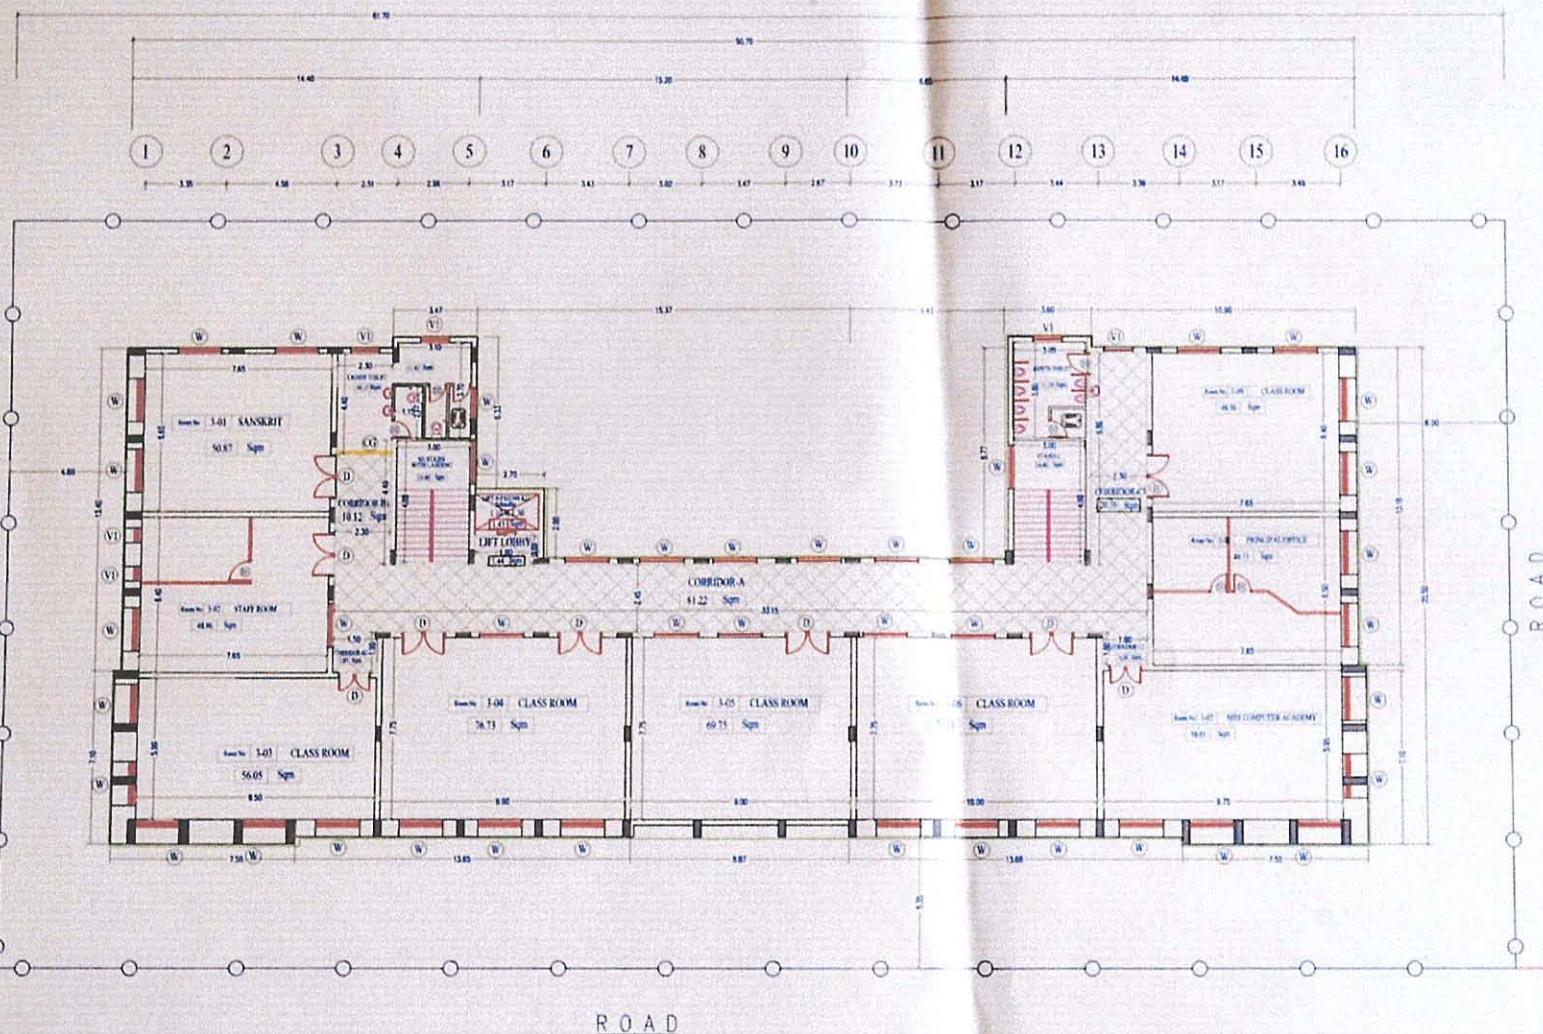


THIRD FLOOR

PLINTH AREA- 851.50 SQ.M
CARPET AREA- 719.19 SQ.M
ROOF HEIGHT- 3.60 M

SCHEDULE OF OPENINGS

SL.NO	IND.	SIZE
1.	D DOOR	1.80 X 2.10
2.	D1 DOOR	0.90 X 2.10
3.	D2 DOOR	0.75 X 2.10
4.	W WINDOW	1.80 X 1.20
5.	W1 WINDOW	0.90 X 1.20
6.	V VENT.	1.80 X 0.45
7.	V1 VENT.	1.20 X 0.45
8.	V2 VENT.	0.60 X 0.45
9.	CG	COLLAPSIBLE GATE
10.	AP	ALUMINIUM PARTITION

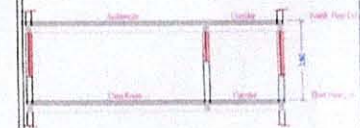

TYPICAL SECTION



REVISED DATE : 15-5-2017
REVISED DATE : 01.05.2017

SCALE : 1:150
DATE : 12-4-2017
DRAWN : BISWAJIT R
CHECKED : MADHAV

THIRD FLOOR AS BUILT DRAWING

NEW CREATION LINE ARCHITECTURE
#190/114, 12TH MAIN, 3RD BLOCK
RAJAJINAGAR, BASHYAM CIRCLE
BANGALORE-560010
cont : 9986491567, 98-0822201296
Email : newcreationlinearchitecture@gmail.com


MES INSTITUTIONS
RAJAJINAGAR
BANGALORE

Sharada S
Principal

MES Institute of Management
Raiajinagar, Bangalore-560 010

SCHEDULE OF OPENINGS

SL NO.	IND.		SIZE
1.	D	DOOR	1.80 X 2.10
2.	D1	DOOR	0.90 X 2.10
3.	D2	DOOR	0.75 X 2.10
4.	W	WINDOW	1.80 X 1.20
5.	W1	WINDOW	0.90 X 1.20
6.	V	VENT.	1.80 X 0.45
7.	V1	VENT.	1.20 X 0.45
8.	V2	VENT.	0.60 X 0.45
9.	CG	COLLAPSIBLE GATE	
10.	AP	ALUMINIUM PARTITION	

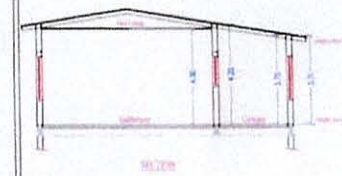

REVISED DATE : 15-5-2017

REVISED DATE : 01.05.2017

SCALE : 1:150

DATE : 12-4-2017

DRAWN : BISWAJIT R

CHECKED : MADHAV

FOURTH FLOOR AS BUILT DRAWING

NEW CREATION LINE ARCHITECTURE

#190/114, 12TH MAIN, 3RD BLOCK

RAJAJINAGAR, BASHYAM CIRCLE,

BANGALORE-560010

cont: 966491967, off: 0823201266

Email: newcreationlinearchitecture@gmail.com

MES INSTITUTIONS
RAJAJINAGAR
BANGALORE

FOURTH FLOOR

PLINTH AREA: 851.20 SQ. M
CARPET AREA: 790.96 SQ. M
ROOF HEIGHT: 3.60 M

Sharaela S

Vidya Vihara No.25/1 17th Main
2nd Block Rajajinagar
Bengaluru


411

Dated : 27-Dec-23

₹ 56,664.00

Shamala S
Authorised Signatory

Principal

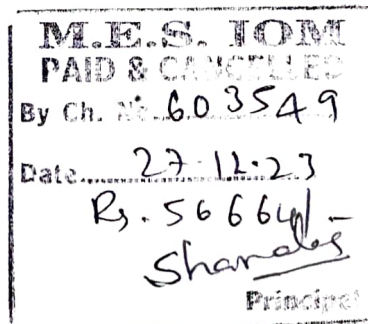



KARNATAKA TEST HOUSE PVT. LTD.


MATERIAL TESTING LABORATORY

No.778/44, 8th Cross, Triveni Road, Gokul 1st Stage, 2nd Phase, Bangalore - 560 054

Tele Fax : 23378383 / 23375326

E-Mail : kthblr@gmail.com Web Site : www.karnatakatesthouse.com

NABL Accredited laboratory as per ISO/IEC 17025

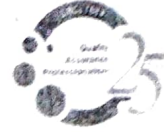

Ref: KTH/ST/QTN/2023-24

Date: 05.12.2023

To,

The principal,

MES Institute of Management,

Rajajinagar, Bangalore - 560010.

Dear Sir/Madam,

Sub: Quotation for Safety check for Annex Building.

With reference to your enquiry regarding the NDT test and safety check for the above subject mentioned by you, we herewith furnish our rates for carrying out the work.

QUOTATION


Sl No	Description	Qty	Rate	Amount
1.	Ultrasonic Pulse Velocity Test Conducting Ultrasonic pulse velocity test for compressive strength of in-situ concrete on Columns, Beams and Slab at Critical points using "PUNDIT" (Portable ultrasonic non-destructive Digital Indicating Tester), as per the guidelines in Indian Standards (IS: 516 (Part 5/Sec 1):2018)	40	500.00	20,000.00
2.	Rebound Hammer Test Conducting Rebound Hammer Test for compressive strength of in-situ concrete as per Indian Standards IS: 516 (Part 5/Sec 4):2020	24	500.00	12,000.00
3.	Recognisance, visual inspection of Building-cracks, rusting of reinforcement, distress etc. Recommendation, preparing and submission of report in duplicate	Ls	15,000.00	15,000.00
4.	Mobilization Transportation of equipment and technical personnel.	1 day	2,000.00	2,000.00
			Total	49,000.00
			GST extra at 18% on bill amount	8,820.00
			Gross Total	57,820.00

Shamdas

PRINCIPAL

MES Institute of Management
Rajajinagar, Bangalore - 560 010

PAN NO - AAACK 69491H

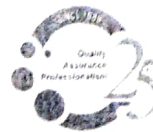

28/12/2022